

1 OFFICE LEVEL 2
A102 1/8" = 1'-0"


FLOOR PLAN - GENERAL NOTES

- WORK NOTED BY OTHERS OR "N/C" SHALL BE PROVIDED BY OWNER OR UNDER SEPARATE CONTRACT
- SEE SHEET A200 FOR PARTITION TYPES
- SEE SHEET A201 FOR DOOR TYPES AND DETAILS
- PROVIDE CONTROL JOINTS ON GYP. BD. ASSEMBLES PER SPECIFICATIONS AND WHERE SHOWN
- EXTEND WALLS TO DECK ABOVE STOREFRONT SYSTEMS AND GLASS WALL PARTITIONS
- REVIEW DOCUMENTS AND VERIFY DIMENSIONS AND FIELD CONDITIONS WHEN APPLICABLE. CONFIRM THAT WORK IS BUILDABLE AS SHOWN. ANY CONFLICTS OR OMISSIONS SHALL BE IMMEDIATELY REPORTED TO THE ARCHITECT FOR CLARIFICATION PRIOR TO THE PERFORMANCE OF WORK IN QUESTIONS
- COORDINATE AND PROVIDE METAL OR RATED SOLID WOOD BLOCKING FIRE TREATED IN PARTITIONS AND CEILING FOR MILLWORK, WALL AND CEILING ATTACHED ITEMS AS SPECIFIED. DO NOT SCALE DRAWINGS. WRITTEN DIMENSIONS GOVERN. ALL PARTITION LOCATIONS, DIMENSIONS AND TYPES, DOOR AND WINDOW LOCATIONS SHALL BE AS SHOWN ON PARTITION PLAN. IN CASE OF CONFLICT, NOTIFY ARCHITECT
- COORDINATE WITH TENANT AND OWNER, THE SCHEDULE FOR TELEPHONE, DATA, SECURITY AND AUDIO VISUAL INSTALLATIONS. PARTITIONS AT BUILDING PERIMETER SHALL BE CENTERED ON CENTER LINE OF COLUMN OR WINDOW MULLION, UNLESS OTHERWISE NOTED
- PROVIDE PARTITION TYPE WITH THE HIGHEST UL AND/OR ACoustical PERFORMANCE RATING WHERE MORE THAN ONE PARTITION TYPE IS INDICATED. PARTITIONS SHALL BE HEAD CONDITION 'A' UNLESS OTHERWISE NOTED
- OFFSET ELECTRICAL AND TELEPHONE OUTLETS 16" MINIMUM IN SEPARATE STUD WALL CAVITIES
- PROVIDE ACOUSTIC SOUNDS BATS ABOVE ALL DEMOUNTABLE PARTITION WALLS. EXTEND 3'-0" BOTH SIDES OF PARTITION.

MILLWORK - GENERAL NOTES

- ALL CABINET WORK SHALL BE DONE IN ACCORDANCE WITH ARCHITECTURAL WOODWORK STANDARDS FOR CUSTOM GRADE.
- CABINET CONTRACTOR SHALL VERIFY ALL DIMENSIONS IN THE FIELD FOR BUILT-IN WORK PRIOR TO FABRICATION
- CABINET CONTRACTOR SHALL COORDINATE ALL NECESSARY WOOD BLOCKING IN CONJUNCTION WITH HIS WORK INCLUDING BLOCKING REQUIRED FOR THE INSTALLATION OF ANY PREFABRICATED CABINETS
- ALL WOODWORKING AND BLOCKING ATTACHED TO THE PREMISES SHALL BE FIRE RETARDANT IN ACCORDANCE WITH LOCAL BUILDING CODES
- ALL SURFACES THAT ARE TO RECEIVE PLASTIC LAMINATE FINISHES SHALL ALSO HAVE FINISHED MATERIALS ON ALL EXPOSED EDGES, WHERE APPLICABLE, TO PROVIDE A "BALANCED" CONSTRUCTION
- CONTRACTOR SHALL SUBMIT SHOP DRAWINGS FOR LITTLE'S REVIEW IN ACCORDANCE WITH GENERAL CONDITIONS OF THIS PROJECT.
- PLASTIC LAMINATE SHALL BE ONE SINGLE SHEET PREMIUM GRADE ON ANY SURFACE. SEAMS, IF REQUIRED, SHALL BE INDICATED ON SHOP DRAWINGS. SEAMS NOT INDICATED ON SHOP DRAWINGS AND FOUND TO BE UNACCEPTABLE SHALL BE CORRECTED AT COST TO MILLWORK CONTRACTOR.
- COORDINATION OF MILLWORK WITH EXISTING AND NEW CONSTRUCTION AND WITH MECHANICAL, FURNITURE OR RELATED ELEMENTS SHALL BE THE RESPONSIBILITY OF THE GENERAL CONTRACTOR.
- CABINET HARDWARE TO BE DESIGNER SELECTED, AS FOLLOWS:
(a) CASEWORK PULLS TO BE HAFELE #106.74.904, #106.74.917, #106.74.929 - NOT SHOWN YET OR OTHERWISE
(b) DRAWER GLIDES TO BE ACCURIDE FULL EXTENSION HEAVY DUTY WITH SOFT CLOSE.
- SEE FINISH PLANS FOR MILLWORK DESCRIPTIONS
- ALL PLAM COUNTER TOPS WITH OPENINGS FOR ACCESS TO TRASH BELOW TO RECEIVE ALUM TRIM PER MOCKET. EXACT SIZES TBD / SEE FINISH PLAN FOR LOCATIONS
- ALL SS COUNTER TOPS WITH OPENING FOR ACCESS TO TRASH BELOW TO HAVE FINISHED SS EDGE / EXACT SHAPE & SIZE TBD / SEE FINISH PLAN FOR LOCATIONS
- SEE TA DRAWINGS FOR BLOCKING DETAILS AT RECESSED AV MONITORS

WALL RATING LEGEND

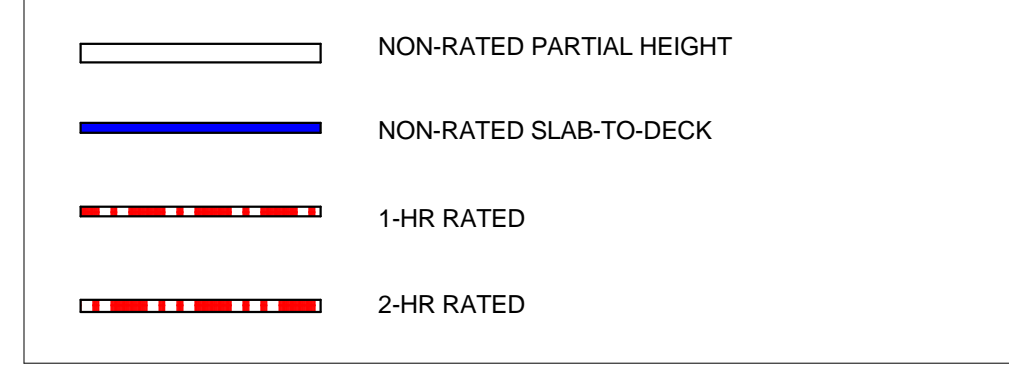

LITTLE
DIVERSIFIED ARCHITECTURAL CONSULTING

5815 Westpark Drive
Charlotte, NC 28217
770.262.4350

www.littleonline.com

This drawing and the design shown are the property of Little Diversified Architectural Consulting. The reproduction, copying or other use of this drawing without their written consent is prohibited and any infringement will be subject to legal action.

© Little 2017

Charlotte Regional Realtor Association

SELWYN PROPERTY GROUP

CONSTRUCTION SERVICES SINCE 1993

Myers & Chapman
Your Building Partner

PAPPAS PROPERTIES

DIVERSIFIED ARCHITECTURAL CONSULTING
CERT. NO. 60033
NORTH CAROLINA
CHARLOTTE, NC

EDWARD LOUIS
REGISTERED ARCHITECT
NORTH CAROLINA
CHARLOTTE, N.C.
51018

ISSUE FOR CONSTRUCTION

ISSUE DATE: 11/13/17

NO.	REASON	DATE
1	Permit Review Comments	12/8/17
2	Addendum #6	01/26/18
3	Modification 1	05/10/18
4	RFI-45 & 47	08/31/18
5	Doors	08/22/18

PROJECT TEAM
PRINCIPAL IN CHARGE: EDDIE PORTIS, AIA
PROJECT MANAGER: TIM LOKEN, AIA


DESIGN TEAM
CHAIR: FDB, CC, JT

PROJECT NAME
CHARLOTTE REGIONAL REALTOR ASSOCIATION - NEW OFFICE
1120 PEARL PARK WAY
CHARLOTTE, NC 28204

PROJECT NO.
132.6273.00


SHEET TITLE
FLOOR PLAN - LEVEL 2

SHEET NUMBER
A102

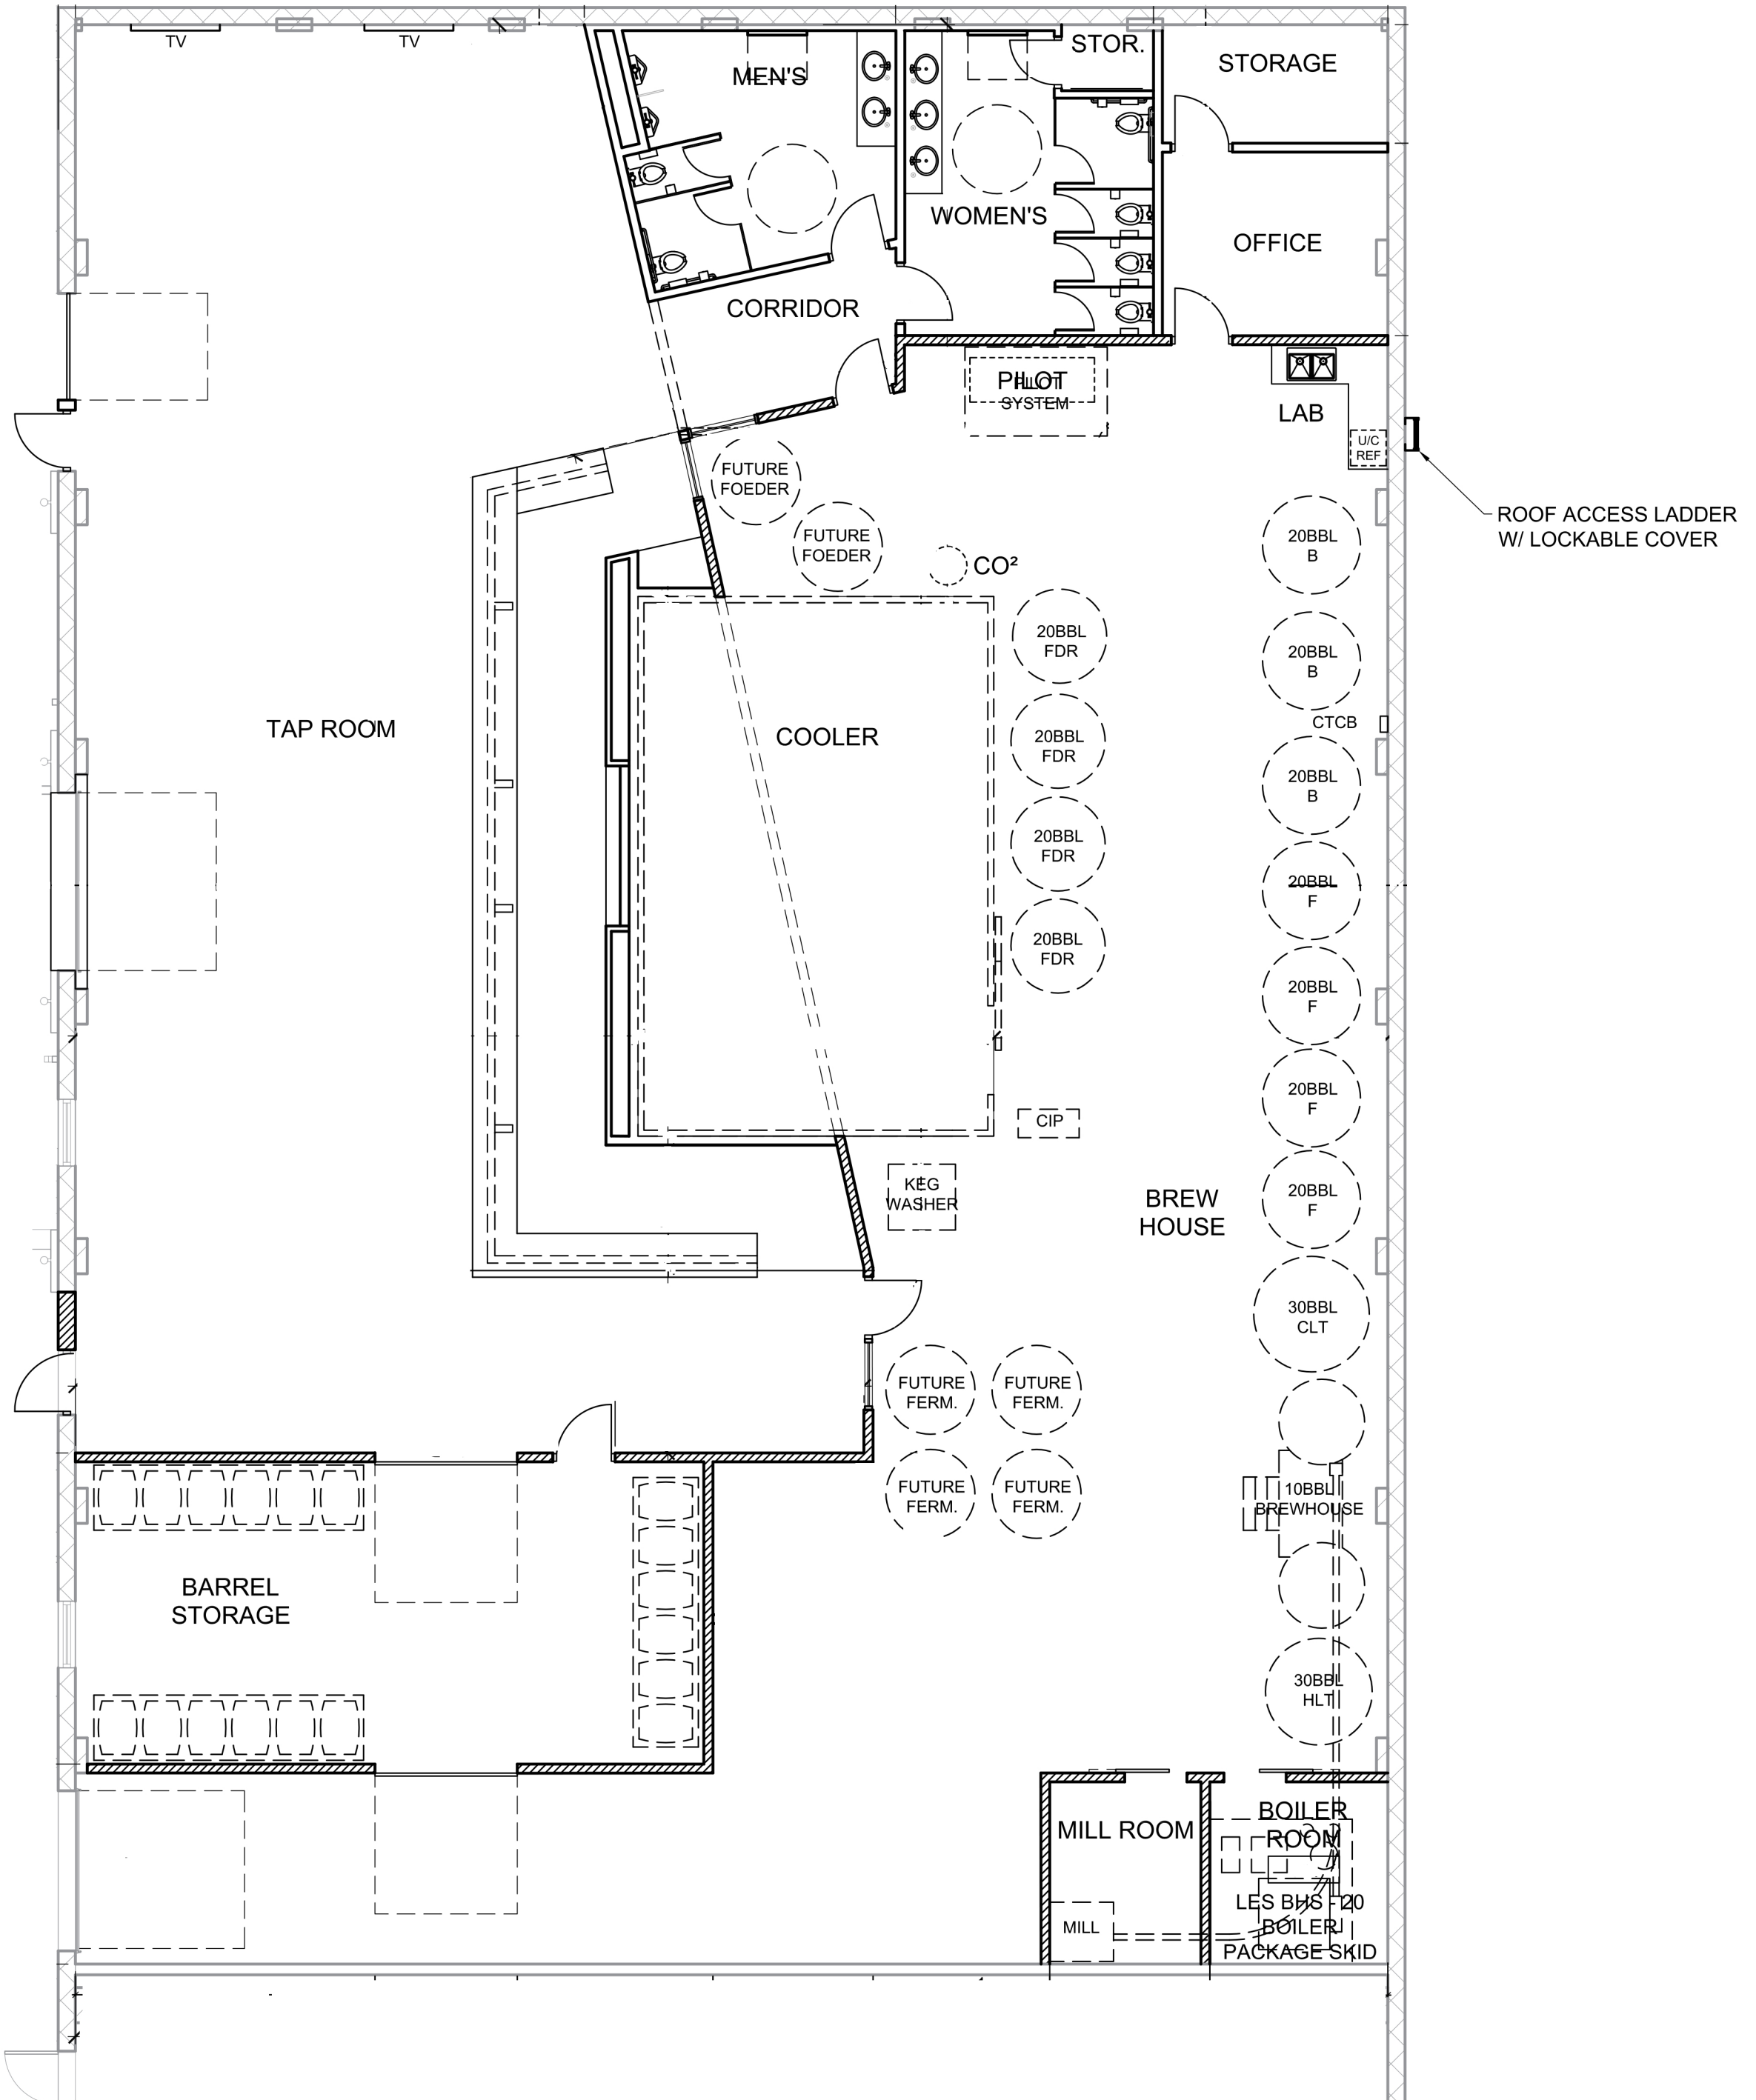


NO.	REASON	DATE
1	MODIFICATION #3	05/19/17
2	ISSUED FOR PERMIT	06/21/17
3	MODIFICATION #6	06/27/17
4	MODIFICATION #7	07/21/17
5	MODIFICATION #8	08/04/17
6	MODIFICATION #10	08/30/17


30 31 32 33 34 35 36 37 38 39 40 41 42 43 44 45 46 47 48 49 50 51 52 53 54 55

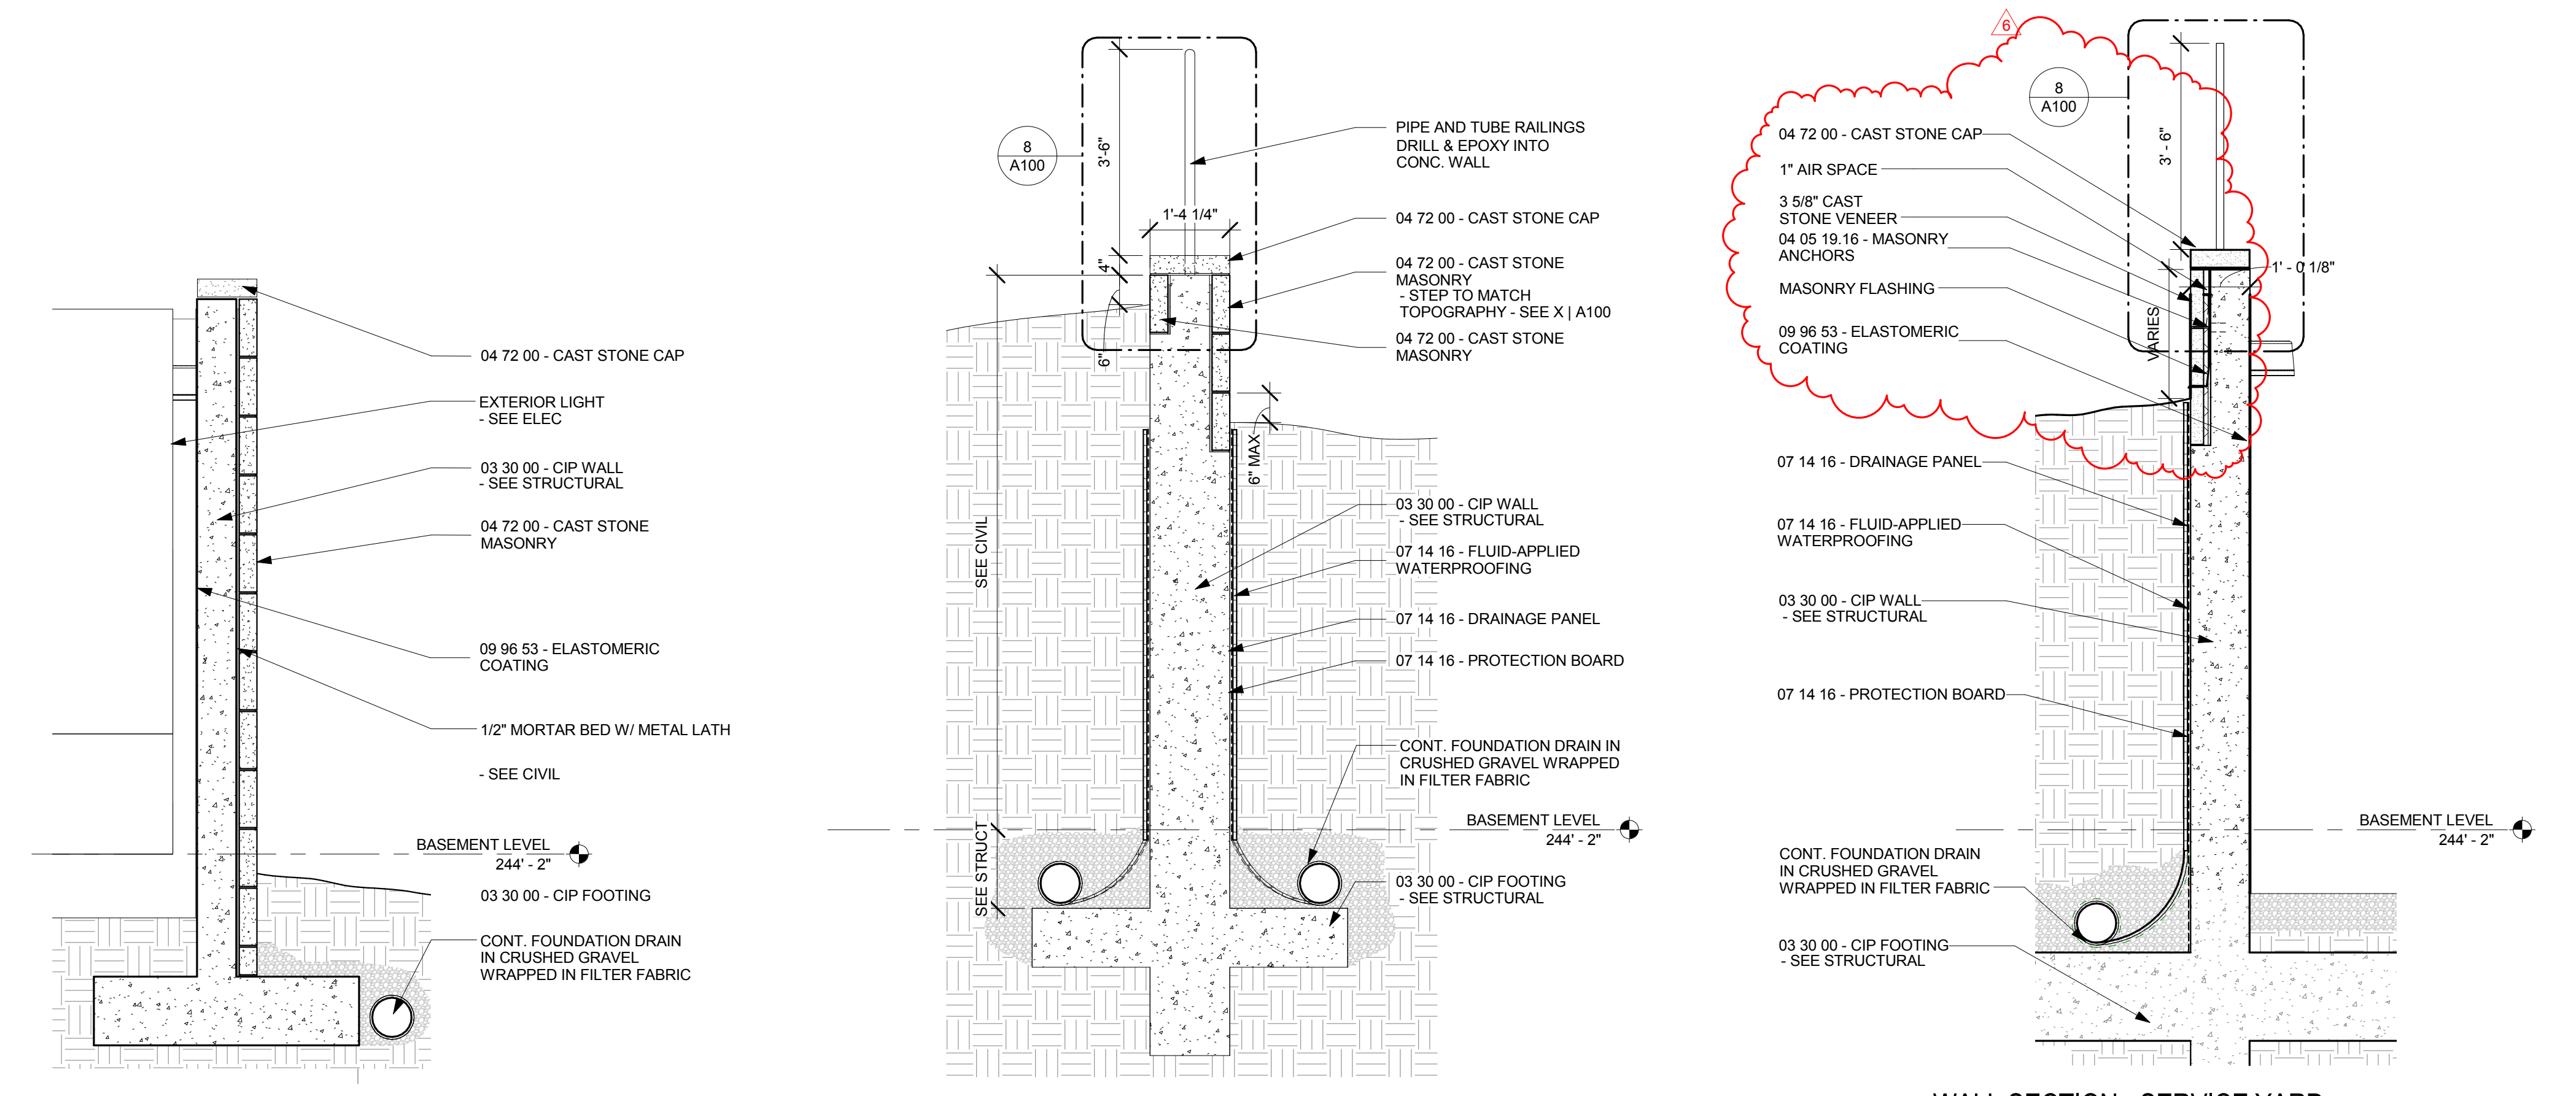


2 WALL SECTION - SERVICE YARD NORTH WALL
A100 1/2" = 1'-0"
9 WALL SECTION - SERVICE YARD WING WALL
A100 1/2" = 1'-0"
3 WALL SECTION - SERVICE YARD
A100 1/2" = 1'-0"

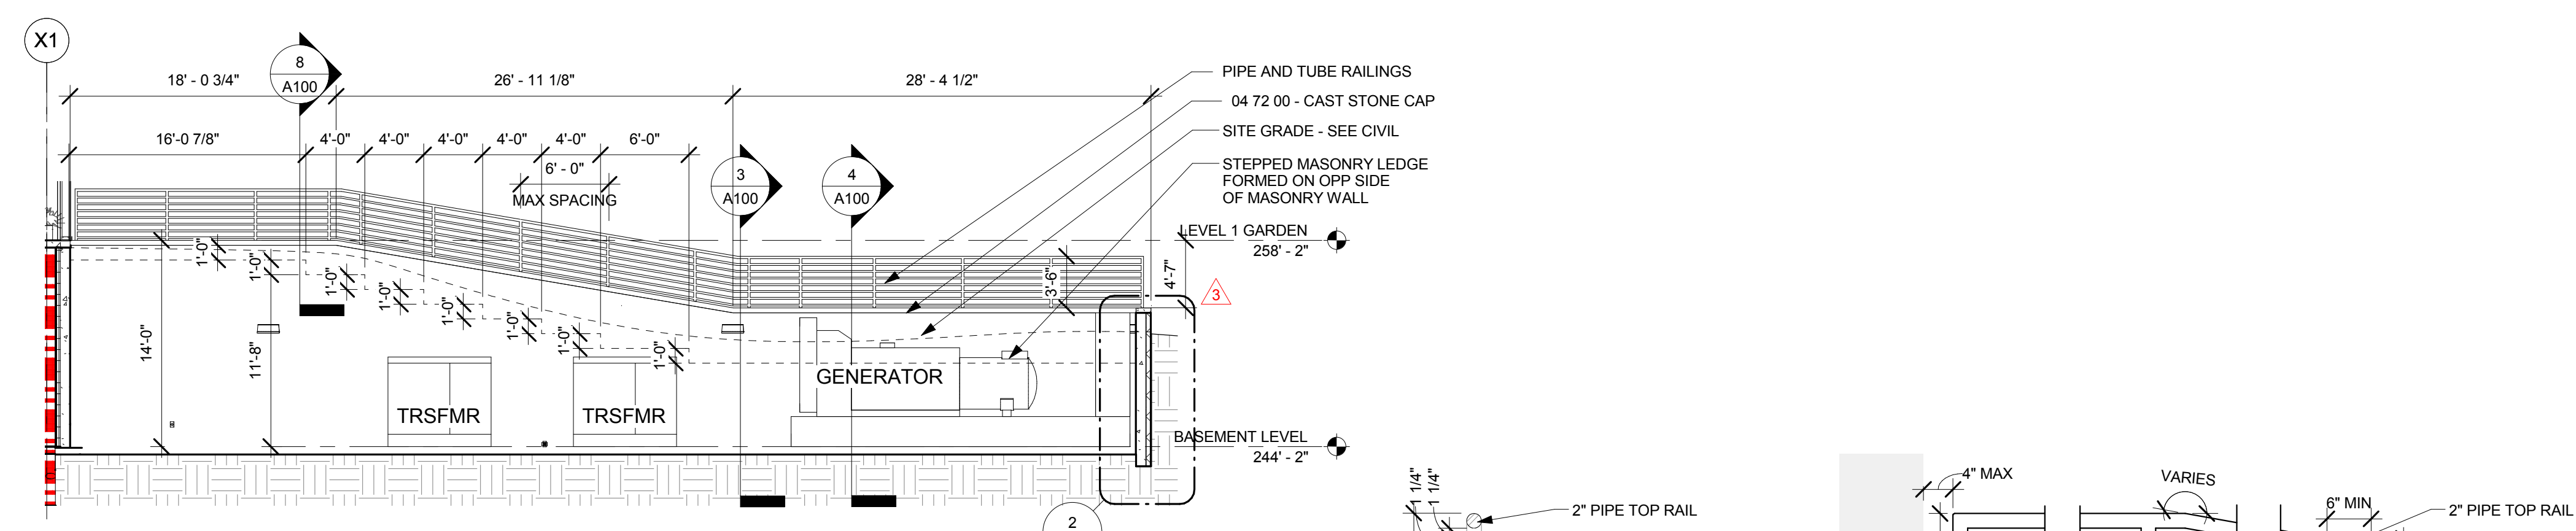


5 BUILDING SECTION - SERVICE YARD
A100 1/8" = 1'-0"
8 EXTERIOR GUARD RAIL DETAIL
A100 3/4" = 1'-0"

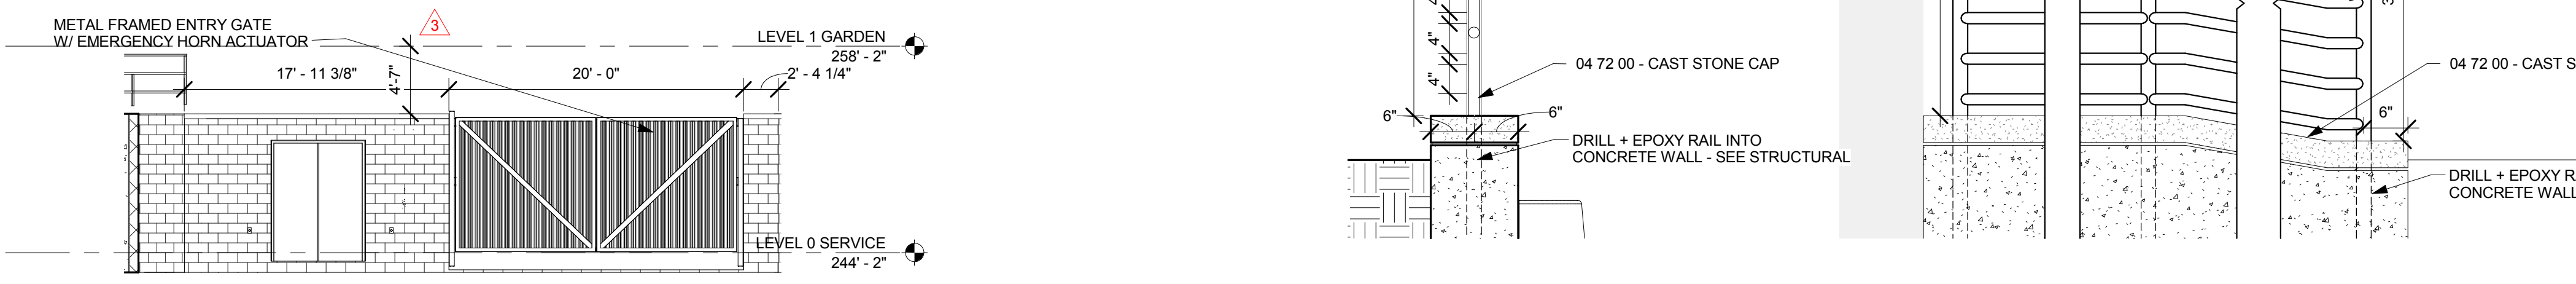



6 EXTERIOR ELEVATION - SERVICE GATE
A100 1/8" = 1'-0"
8 EXTERIOR GUARD RAIL DETAIL
A100 3/4" = 1'-0"

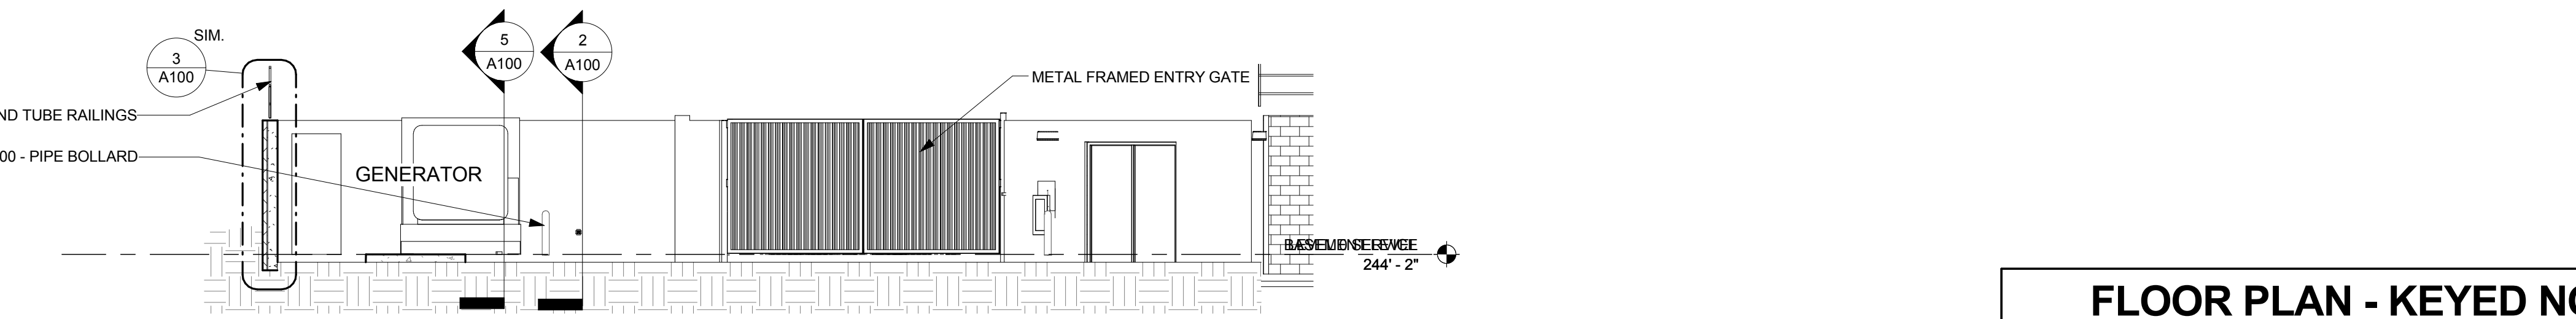

4 BUILDING SECTION - SERVICE YARD
A100 1/8" = 1'-0"
10 EXTERIOR ELEVATION - SERVICE YARD NORTH
A100 1/8" = 1'-0"

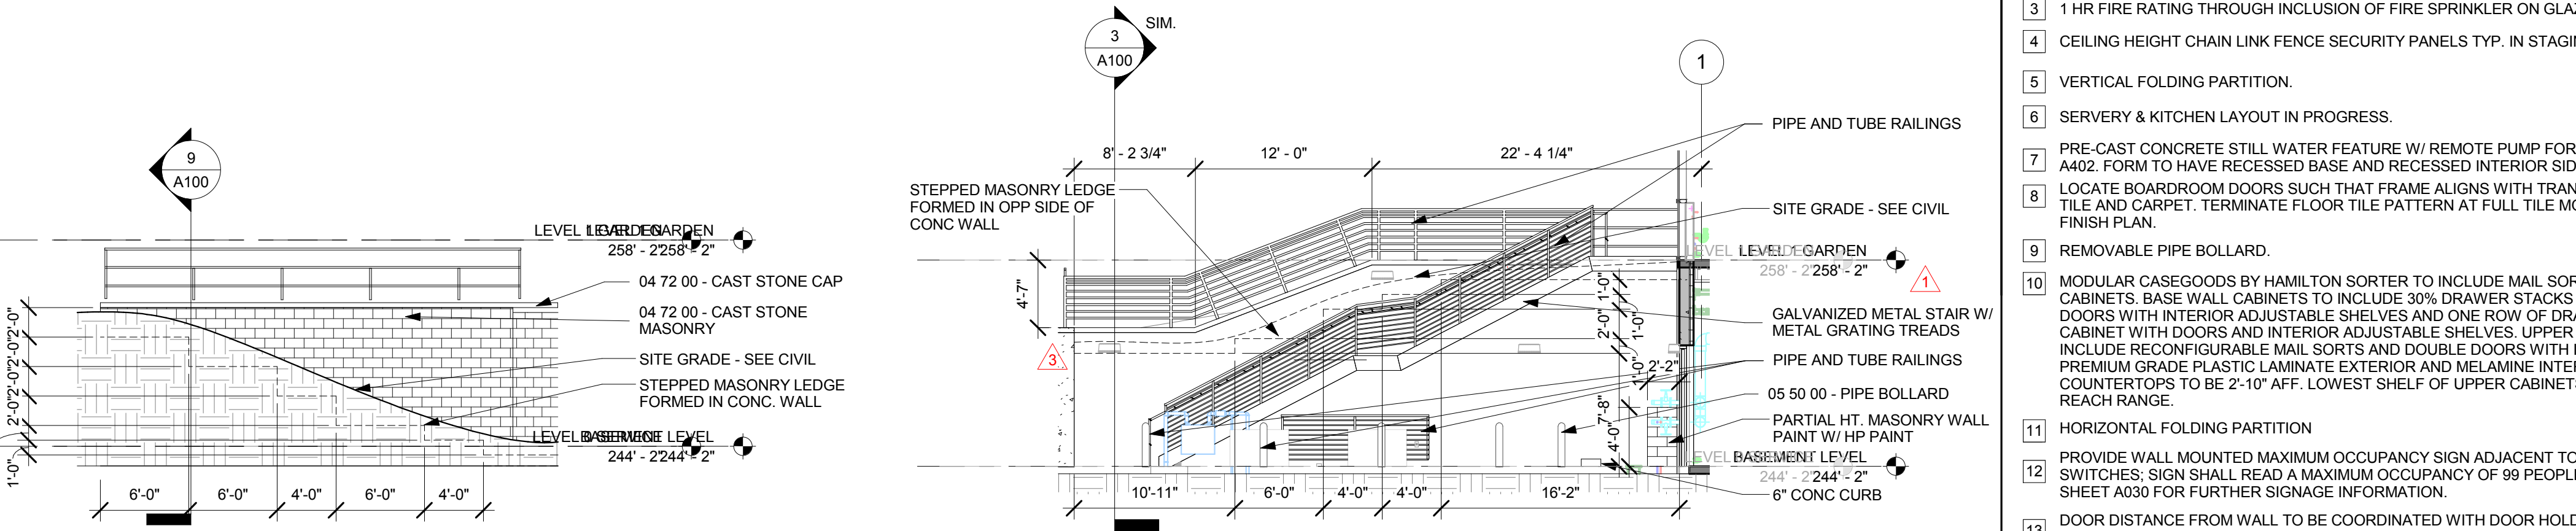

7 ELEVATION - SERVICE YARD EAST WALL
A100 1/8" = 1'-0"
10 EXTERIOR ELEVATION - SERVICE YARD NORTH
A100 1/8" = 1'-0"

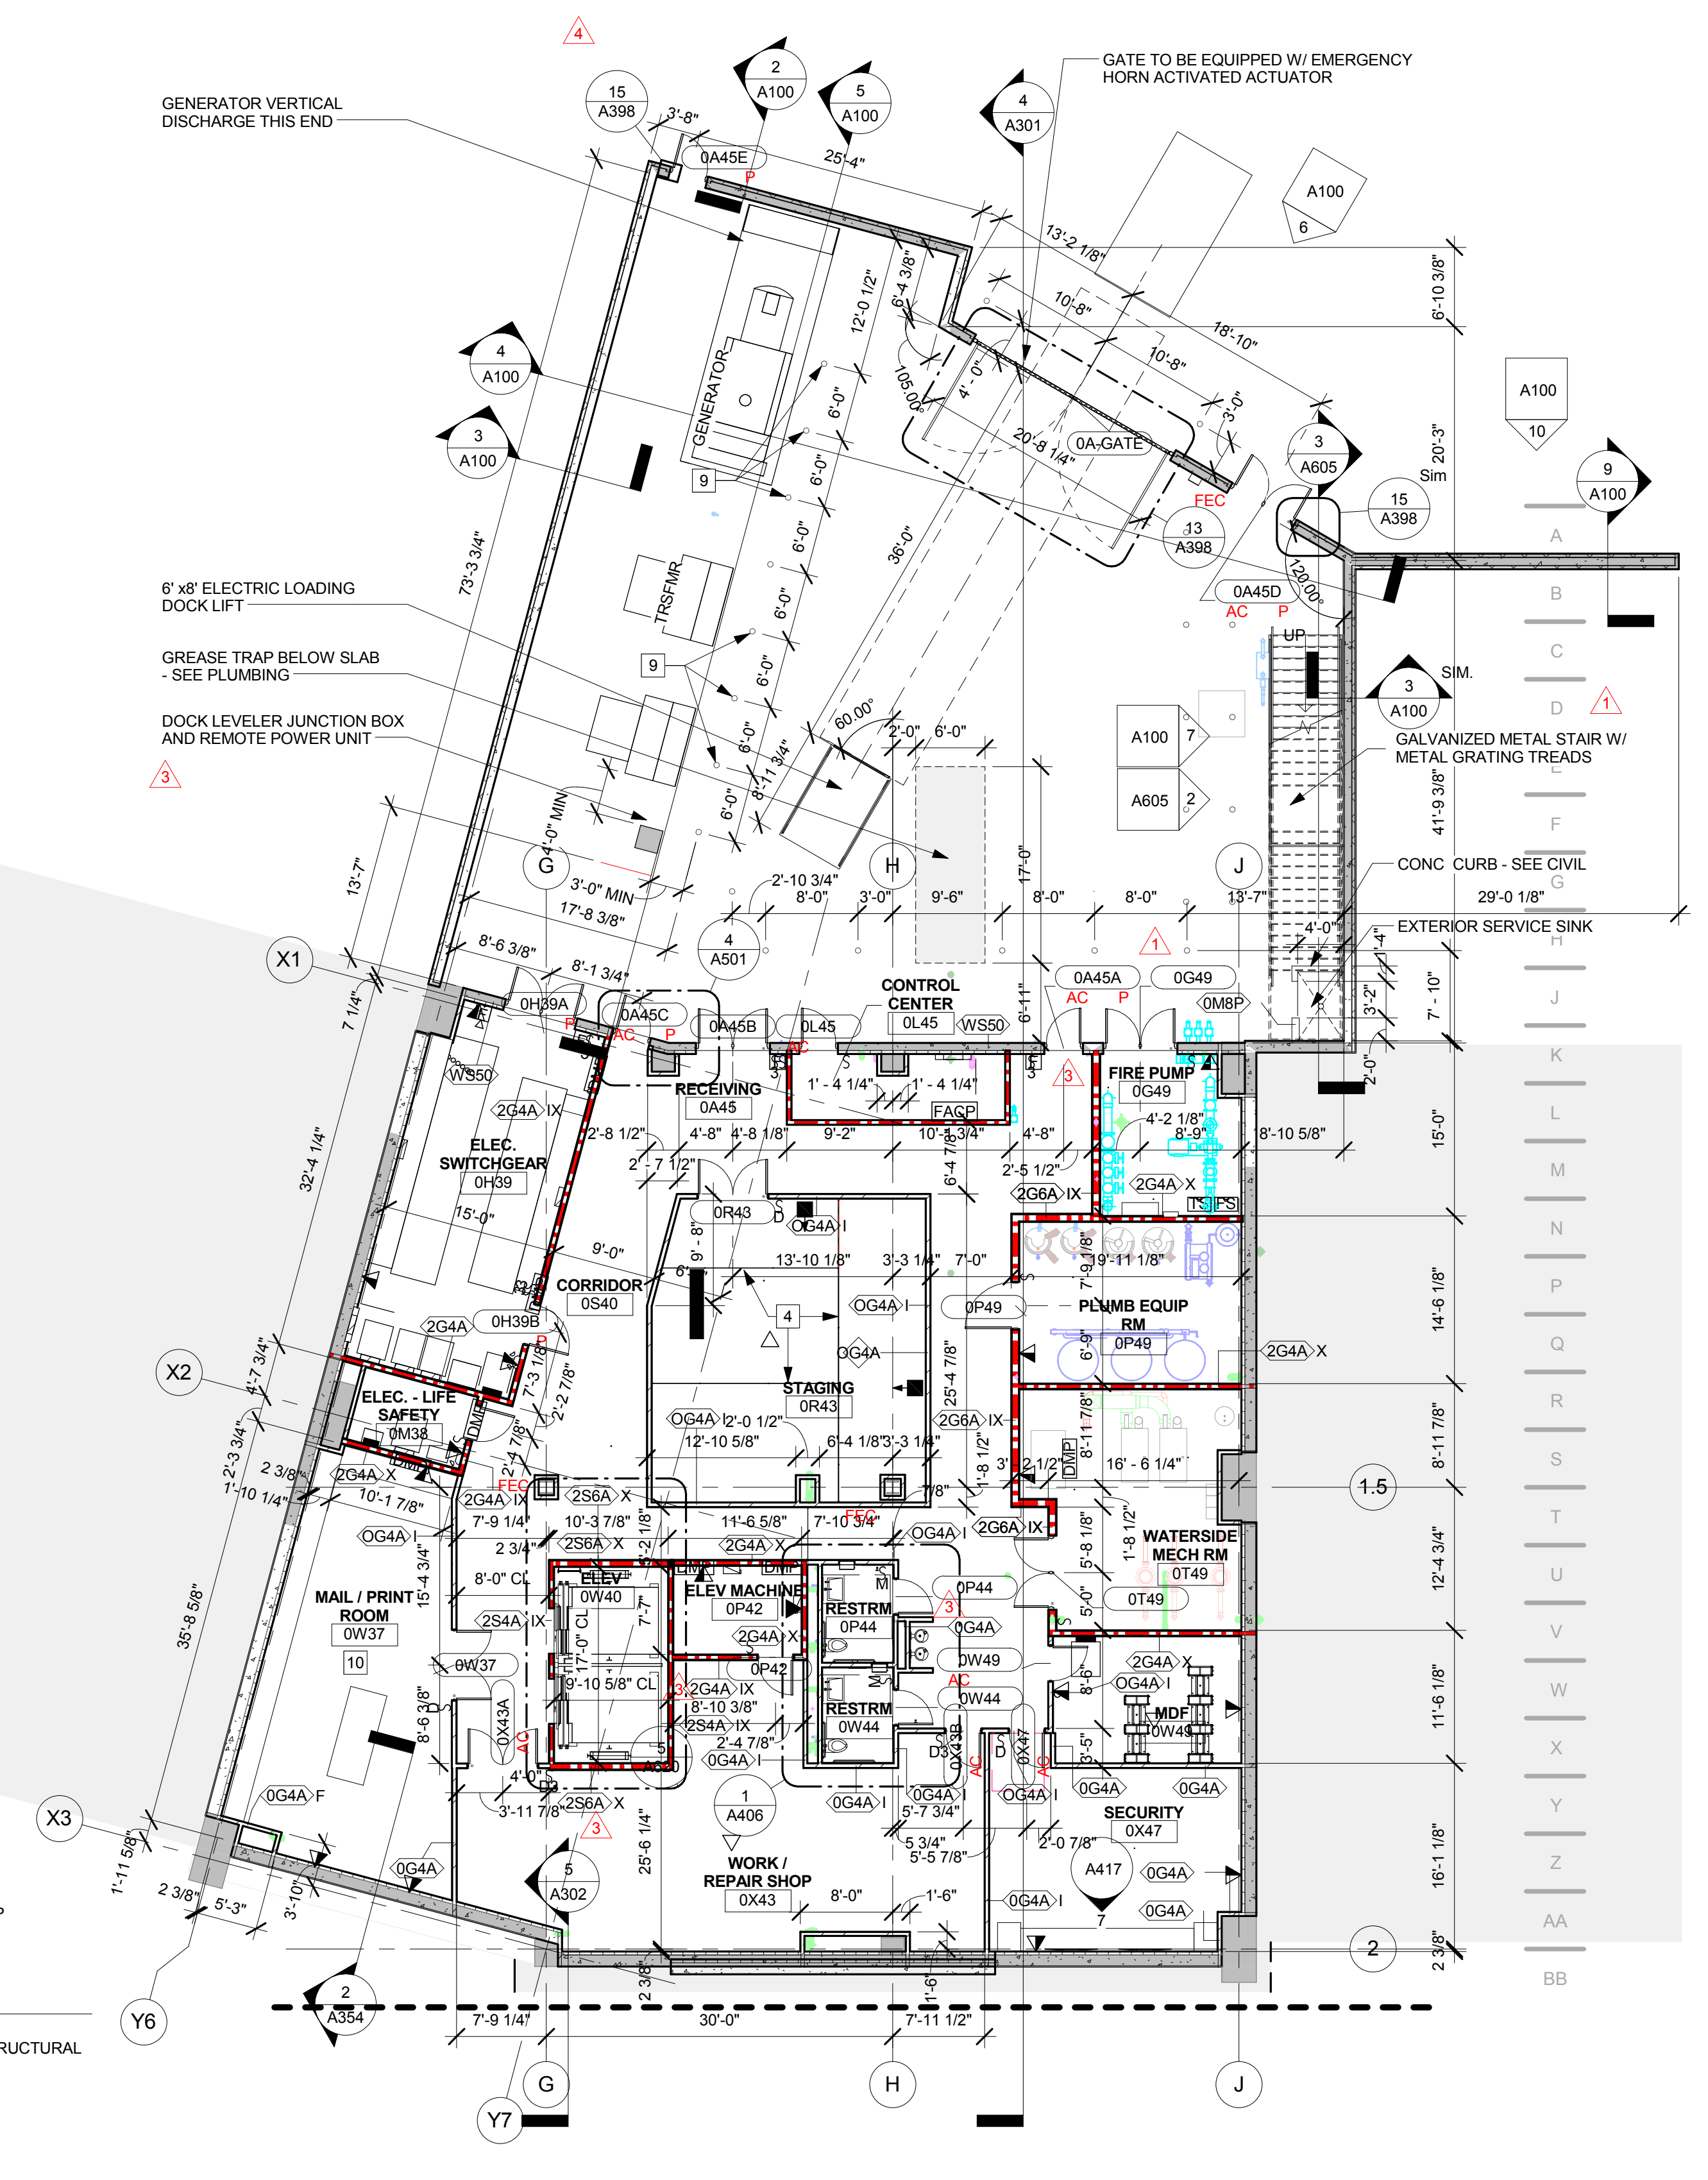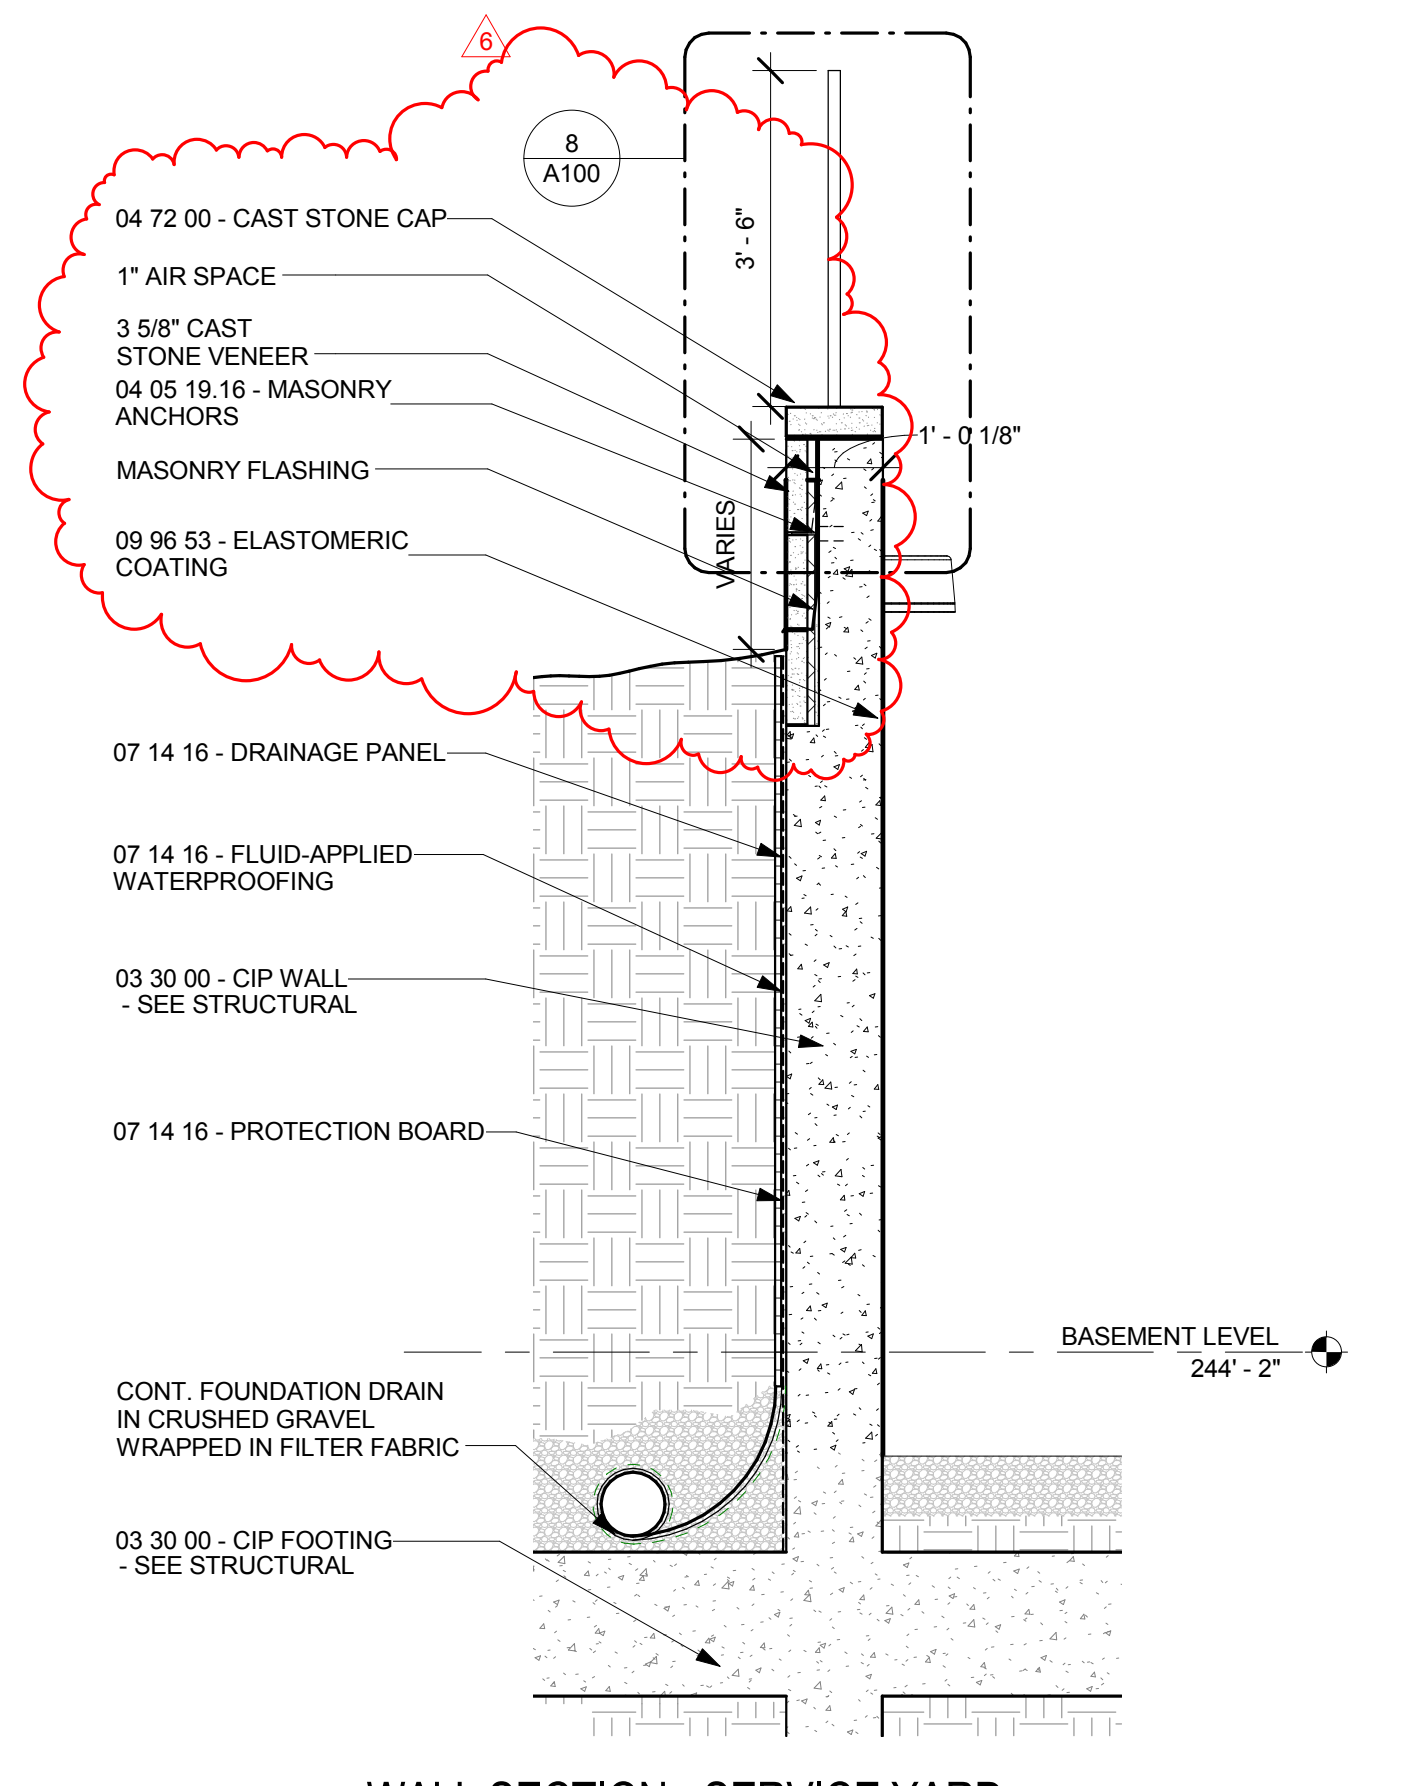


1 FLOOR PLAN - BASEMENT
A100 3/32" = 1'-0"

RATED WALL LEGEND

1-HR RATED PARTITION	
2-HR RATED PARTITION	


- FLOOR PLAN - KEYED NOTES**
- FIRE EXTINGUISHER & CABINET AT THIS LOCATION. PROVIDE REQUIRED QUANTITY ON EACH FLOOR PER CODE AND/OR AHJ. SEE A020 FOR TYP. INSTALLATION DETAILS AND REFER TO LIFE SAFETY PLANS FOR ALL EXTINGUISHER LOCATIONS.
 - BRACKET-MOUNTED FIRE EXTINGUISHER AT THIS LOCATION. PROVIDE REQUIRED QUANTITY ON EACH FLOOR PER CODE AND/OR AHJ. SEE A020 FOR TYP. INSTALLATION DETAILS AND REFER TO LIFE SAFETY PLANS FOR ALL EXTINGUISHER LOCATIONS.
 - 1 HR FIRE RATING THROUGH INCLUSION OF FIRE SPRINKLER ON GLAZED PARTITIONS
 - CEILING HEIGHT CHAIN LINK FENCE SECURITY PANELS TYP. IN STAGING - COORD W/ RCP.
 - VERTICAL FOLDING PARTITION.
 - SERVERY & KITCHEN LAYOUT IN PROGRESS.
 - PRE-CAST CONCRETE STILL WATER FEATURE W/ REMOTE PUMP FOR RECIRCULATION. SEE A402 FORM TO HAVE RECESSED BASE AND RECESSED INTERIOR SIDE WALLS AT POOL. LOCATE BOARDROOM DOORS SUCH THAT FRAME ALIGNS WITH TRANSITION AT FLOOR TILE AND CARPET. TERMINATE FLOOR TILE PATTERN AT FULL TILE MODULE - SEE FINISH PLAN.
 - REMOVABLE PIPE BOLLARD.
 - MODULAR CASEGOODS BY HAMILTON SORTER TO INCLUDE MAIL SORTS, COUNTERS, AND CABINETS. BASE WALL CABINETS TO INCLUDE 30% DRAWER STACKS AND 70% DOUBLE DOORS WITH INTERIOR ADJUSTABLE SHELVES AND ONE ROW OF DRAWERS. ISLAND BASE CABINET WITH DOORS AND INTERIOR ADJUSTABLE SHELVES. UPPER WALL CABINETS TO INCLUDE RECONFIGURABLE MAIL SORTS AND DOUBLE DOORS WITH INTERIOR SHELVES. PREMIUM GRADE PLASTIC LAMINATE EXTERIOR AND MELAMINE INTERIOR FINISH. TYP. ALL COUNTERTOPS TO BE 2'-10" AFF. LOWEST SHELF OF UPPER CABINETS TO BE WITHIN 48" MAX. REACH RANGE.
 - HORIZONTAL FOLDING PARTITION
 - PROVIDE WALL MOUNTED MAXIMUM OCCUPANCY SIGN ADJACENT TO WALL SWITCHES. SIGN SHALL READ A MAXIMUM OCCUPANCY OF 99 PEOPLE. REFER TO SHEET A030 FOR FURTHER SIGNAGE INFORMATION.
 - DOOR DISTANCE FROM WALL TO BE COORDINATED WITH DOOR HOLD OPEN HARDWARE - 3-58" DISTANCE COORDINATED WITH RIXSON 998 ELECTROMAGNETIC DOOR HOLDER REACH RANGE.
 - FURR WALL W/ 3-58" STUD AND THEN W/ 2-1/2" STUD TO PROVIDE ARE FOR RECESSED TELEVISION. SEE 12 | A405

- FLOOR PLAN - GENERAL NOTES**
- ALL LINEAR PARTITIONS TO BE 0G4A U.N.O. SEE SHEET A020 FOR PARTITION TYPES.
 - ALL "BOX-OUT", NON-OTHERS BOUNDING WALLS TO BE 0G4B U.N.O. SEE SHEET A020 FOR PARTITION TYPES.
 - WORK NOTED "BY OTHERS" OR "NIC" SHALL BE PROVIDED BY OWNER OR UNDER SEPARATE CONTRACT.
 - SEE SHEET A030 FOR DOOR TYPES AND DETAILS
 - PROVIDE CONTROL JOINTS ON GYP. BD. ASSEMBLIES PER SPECIFICATIONS AND WHERE SHOWN.
 - EXTEND WALLS TO DECK ABOVE STOREFRONT SYSTEMS AND GLASS WALL PARTITIONS.
 - REVIEW DOCUMENTS AND VERIFY DIMENSIONS AND FIELD CONDITIONS WHEN APPLICABLE. CONFIRM THAT WORK IS BUILDABLE AS SHOWN. ANY CONFLICTS OR OMISSIONS SHALL BE IMMEDIATELY REPORTED TO THE ARCHITECT FOR CLARIFICATION PRIOR TO THE PERFORMANCE OF WORK IN QUESTIONS.
 - COORDINATE AND PROVIDE METAL OR RATED SOLID WOOD BLOCKING (FIRE TREATED) IN PARTITIONS AND CEILING FOR MILLWORK, WALL AND CEILING ATTACHED ITEMS AS SPECIFIED.
 - DO NOT SCALE DRAWINGS. WRITTEN DIMENSIONS GOVERN. ALL PARTITION LOCATIONS, DIMENSIONS AND TYPES, DOOR AND WINDOW LOCATIONS SHALL BE AS SHOWN ON PARTITION PLAN. IN CASE OF CONFLICT, NOTIFY ARCHITECT.
 - COORDINATE WITH TENANT AND OWNER, THE SCHEDULE FOR TELEPHONE, DATA, SECURITY AND AUDIO VISUAL INSTALLATIONS.
 - PARTITIONS AT BUILDING PERIMETER SHALL BE CENTERED ON CENTER LINE OF COLUMN OR WINDOW MULLION, UNLESS OTHERWISE NOTED.
 - PROVIDE PARTITION TYPE WITH THE HIGHEST UL AND/OR ACOUSTICAL PERFORMANCE RATING WHERE MORE THAN ONE PARTITION TYPE IS INDICATED. PARTITIONS SHALL BE TYPE 'X' UNLESS OTHERWISE NOTED.
 - OFFSET ELECTRICAL AND TELEPHONE OUTLETS 16" MINIMUM IN SEPARATE STUD WALL CAVITIES.
 - PER DIRECTION FROM THE CITY OF ROSEVILLE, THESE PLANS HAVE BEEN REVIEWED FOR CONFORMANCE WITH 03 CALIFORNIA BUILDING STANDARDS CODE.
 - PER REQUEST FROM THE CITY OF ROSEVILLE, THE SQUARE FOOTAGE OF DEDICATED MEDICAL USE SPACE IS 1,708 SF WHICH INCLUDES: FUNCTIONAL TRAINING 1W57, MOTION LAB 1T58, PHARMACY LOBBY 1W61, PHARMACY 1U62, LAB 1O61, CONSULT 1U65, 1W71, 1W73, E7 1W65, 1W68, EXAM 1U73

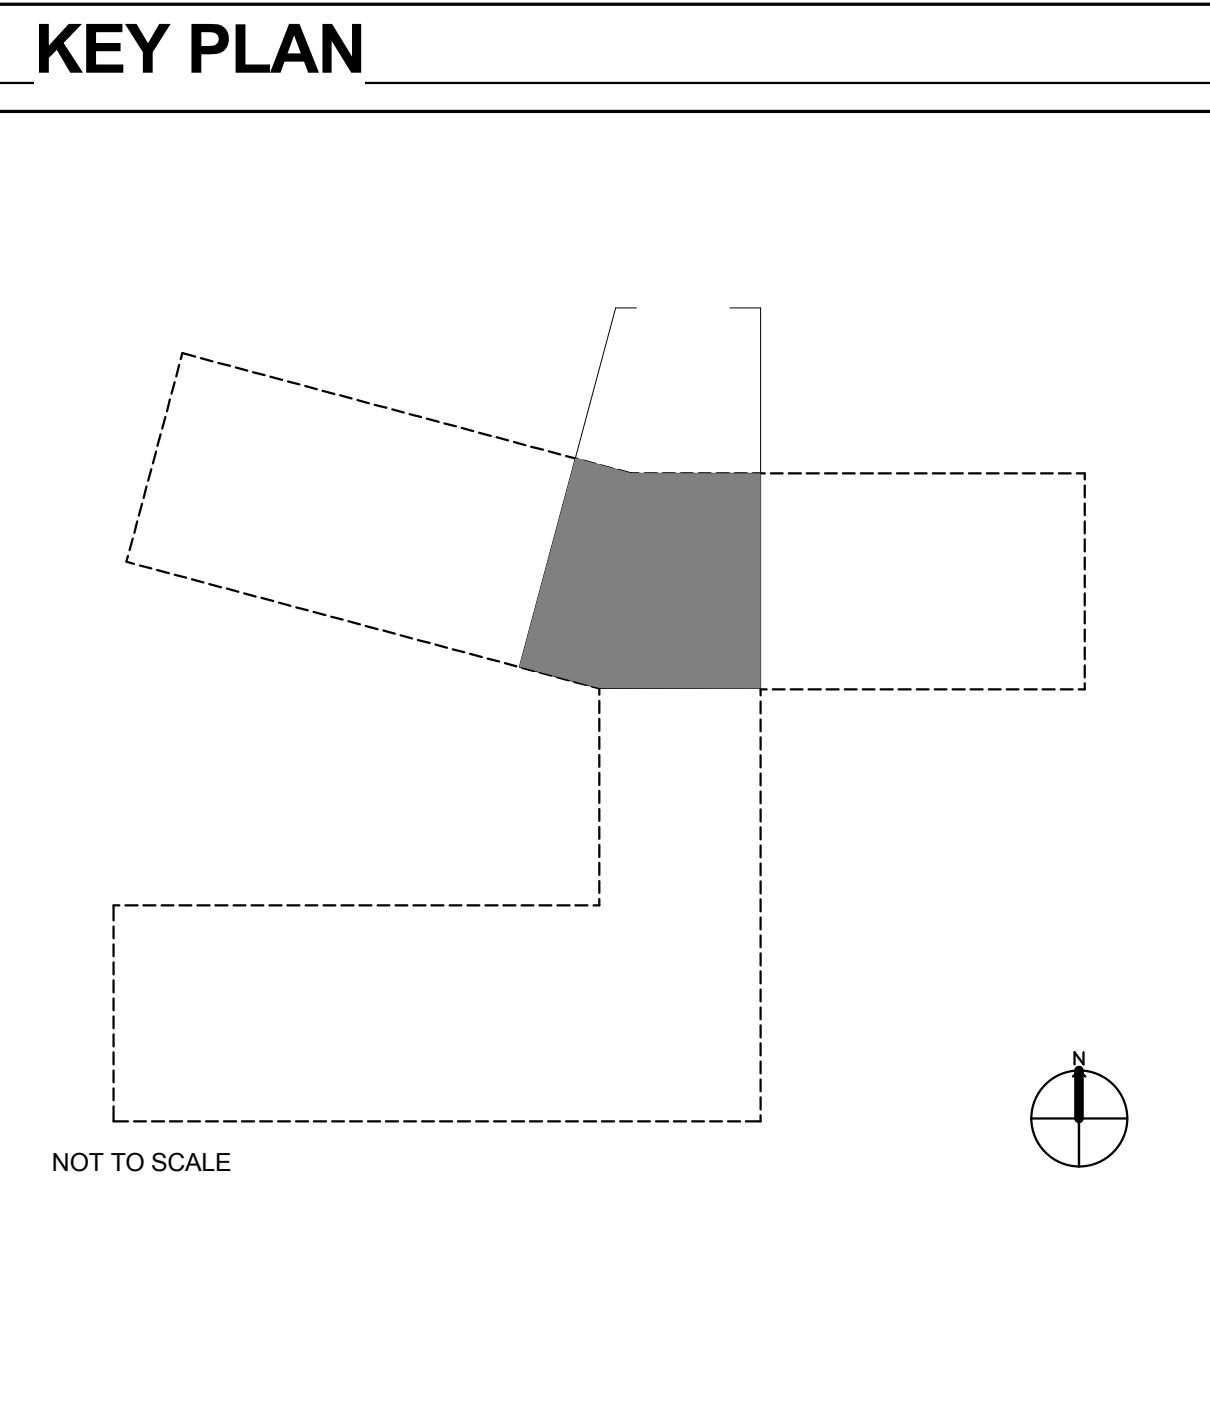



Adventist Health

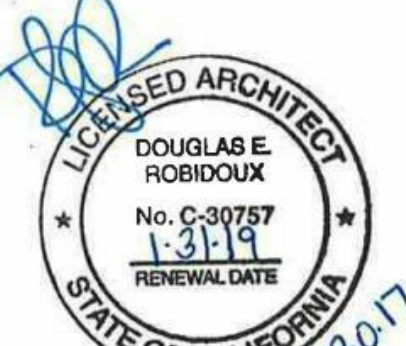

ISSUE FOR

CONSTRUCTION DOCUMENTS

ISSUE DATE

04.05.17

NO.	REVISIONS	REASON	DATE
1	MODIFICATION #3		05/19/17
2	MODIFICATION #5		06/07/17
3	MODIFICATION #6		06/27/17
4	MODIFICATION #7		07/21/17
5	MODIFICATION #8		08/04/17
6	MODIFICATION #10		08/30/17

PERMIT NUMBER: BD16-5774

PERMIT NUMBER: BD17-2189



PROJECT TEAM
PRINCIPAL ARCHITECT: EDIE PORTIN, AIA, LEED AP BD+C
PROJECT MANAGER: FRANK DEBOLT, AIA, LEED AP BD+C
PROJECT DESIGNER: MICHAEL COATES, AIA, NCARB
PROJECT NAME: SHARED SERVICES CAMPUS

One Adventist Health Way
Roseville, California 95661

PROJECT NO.
132.4960.00

SHEET TITLE
FLOOR PLAN - LEVEL 1 - NORTH BAR

SHEET NUMBER
A101-N

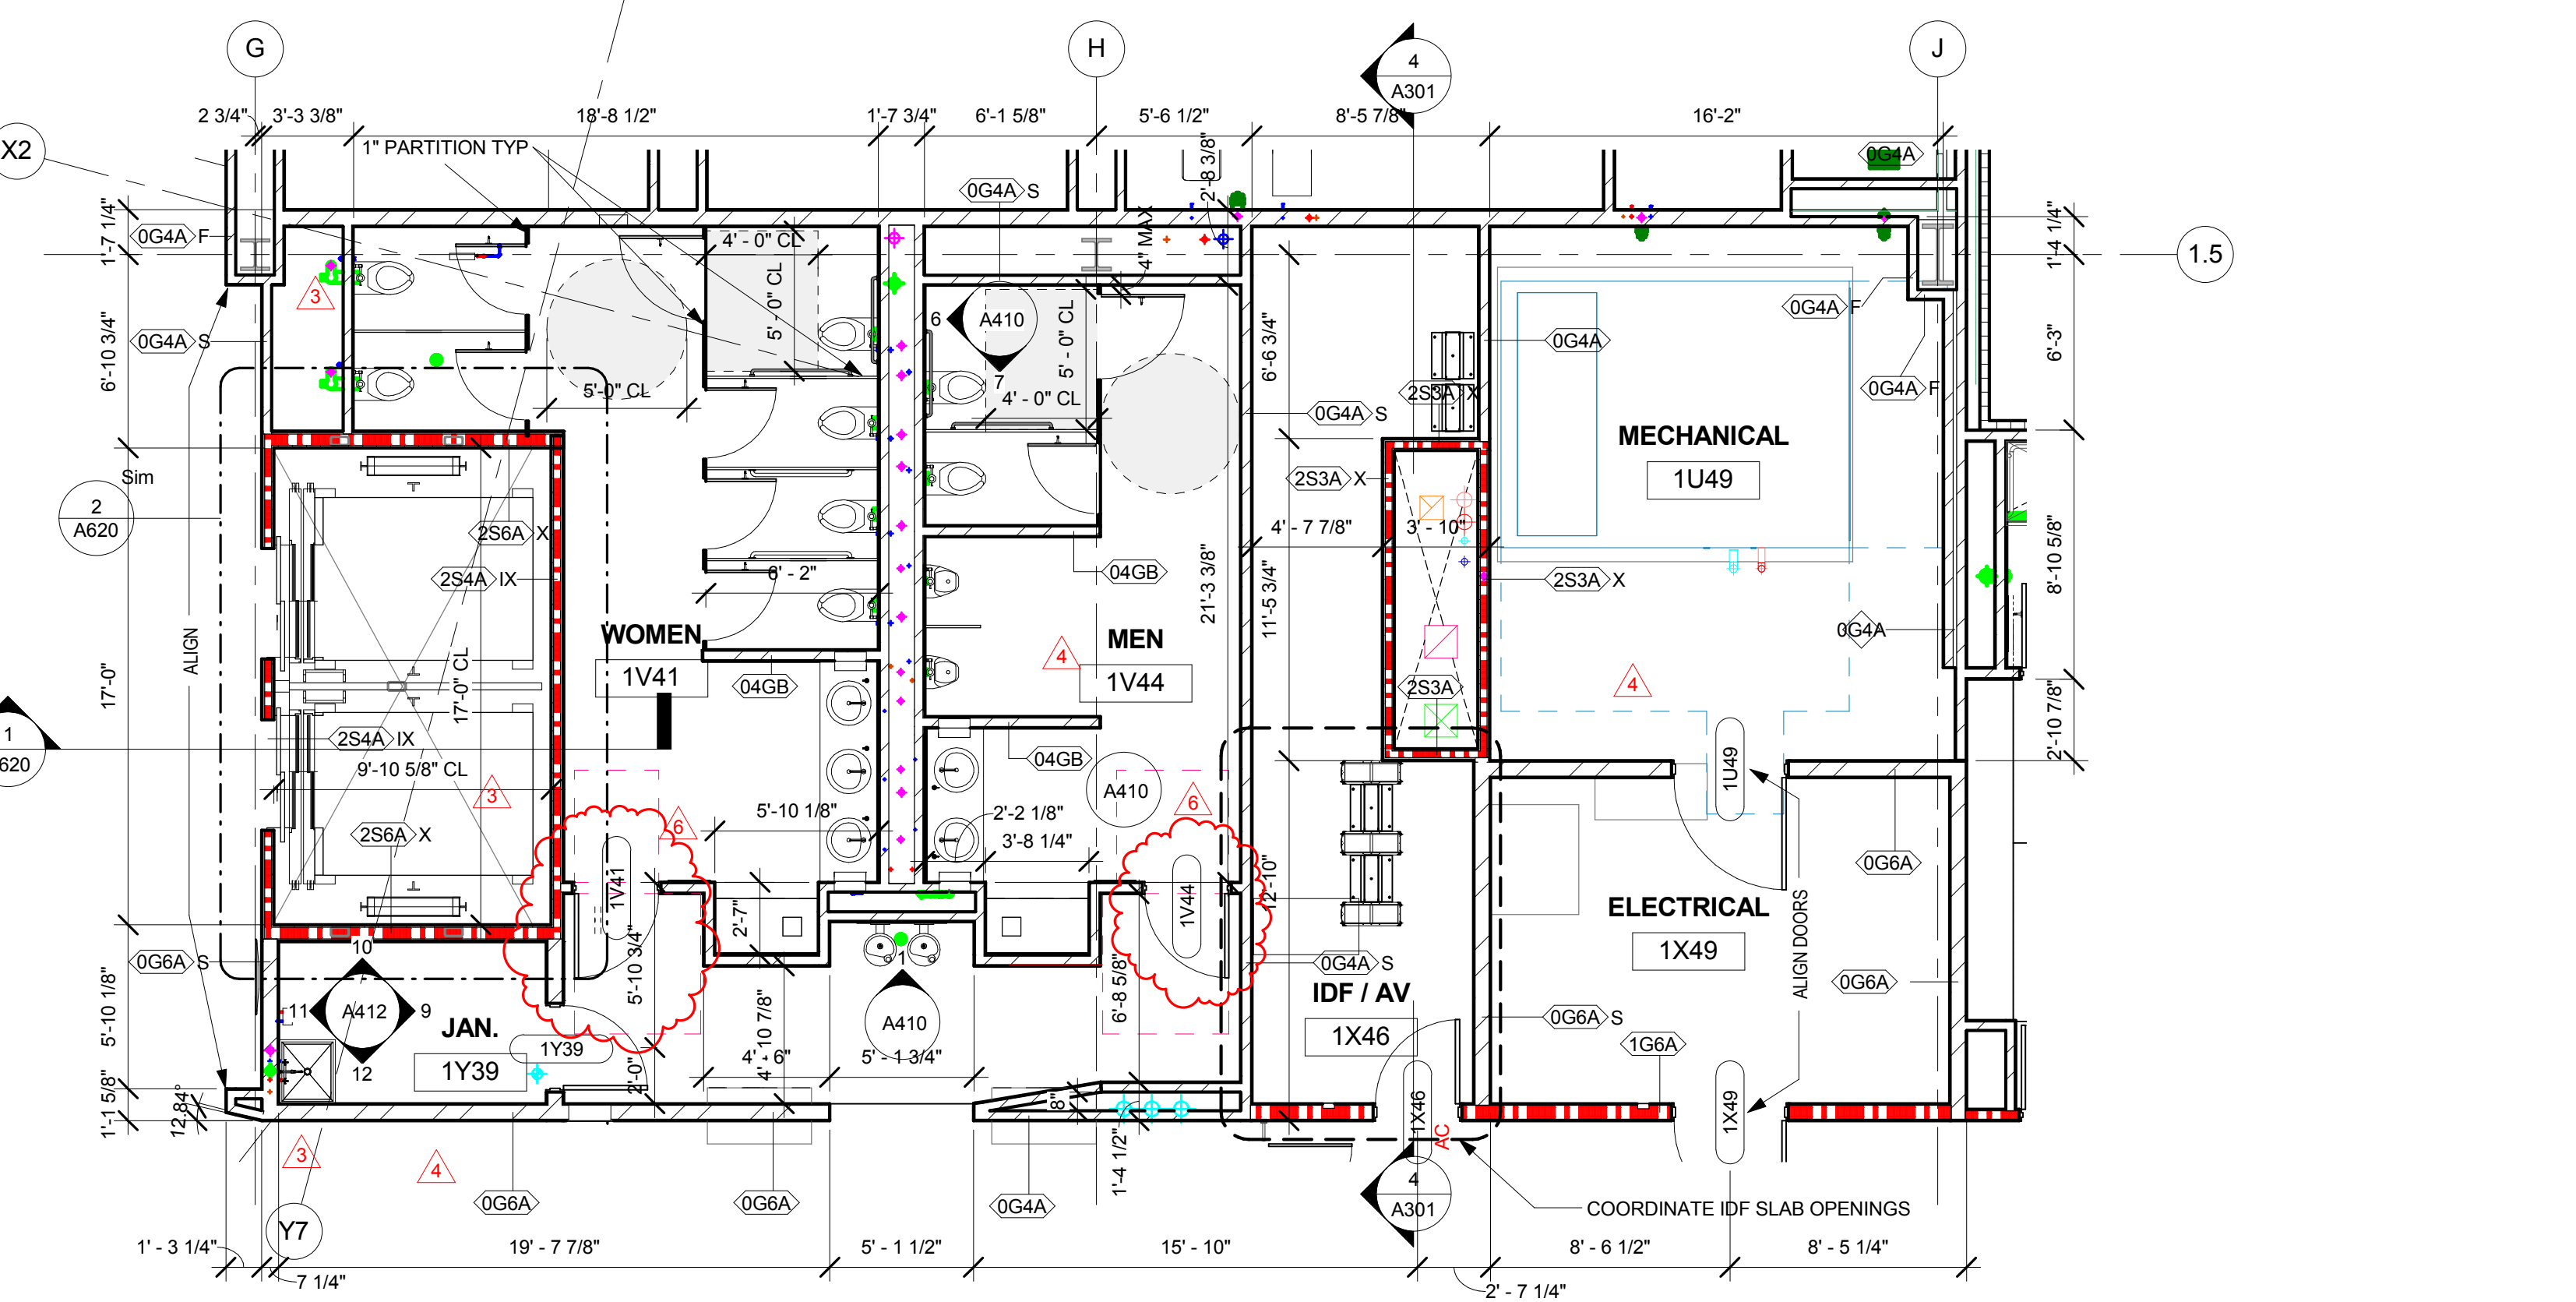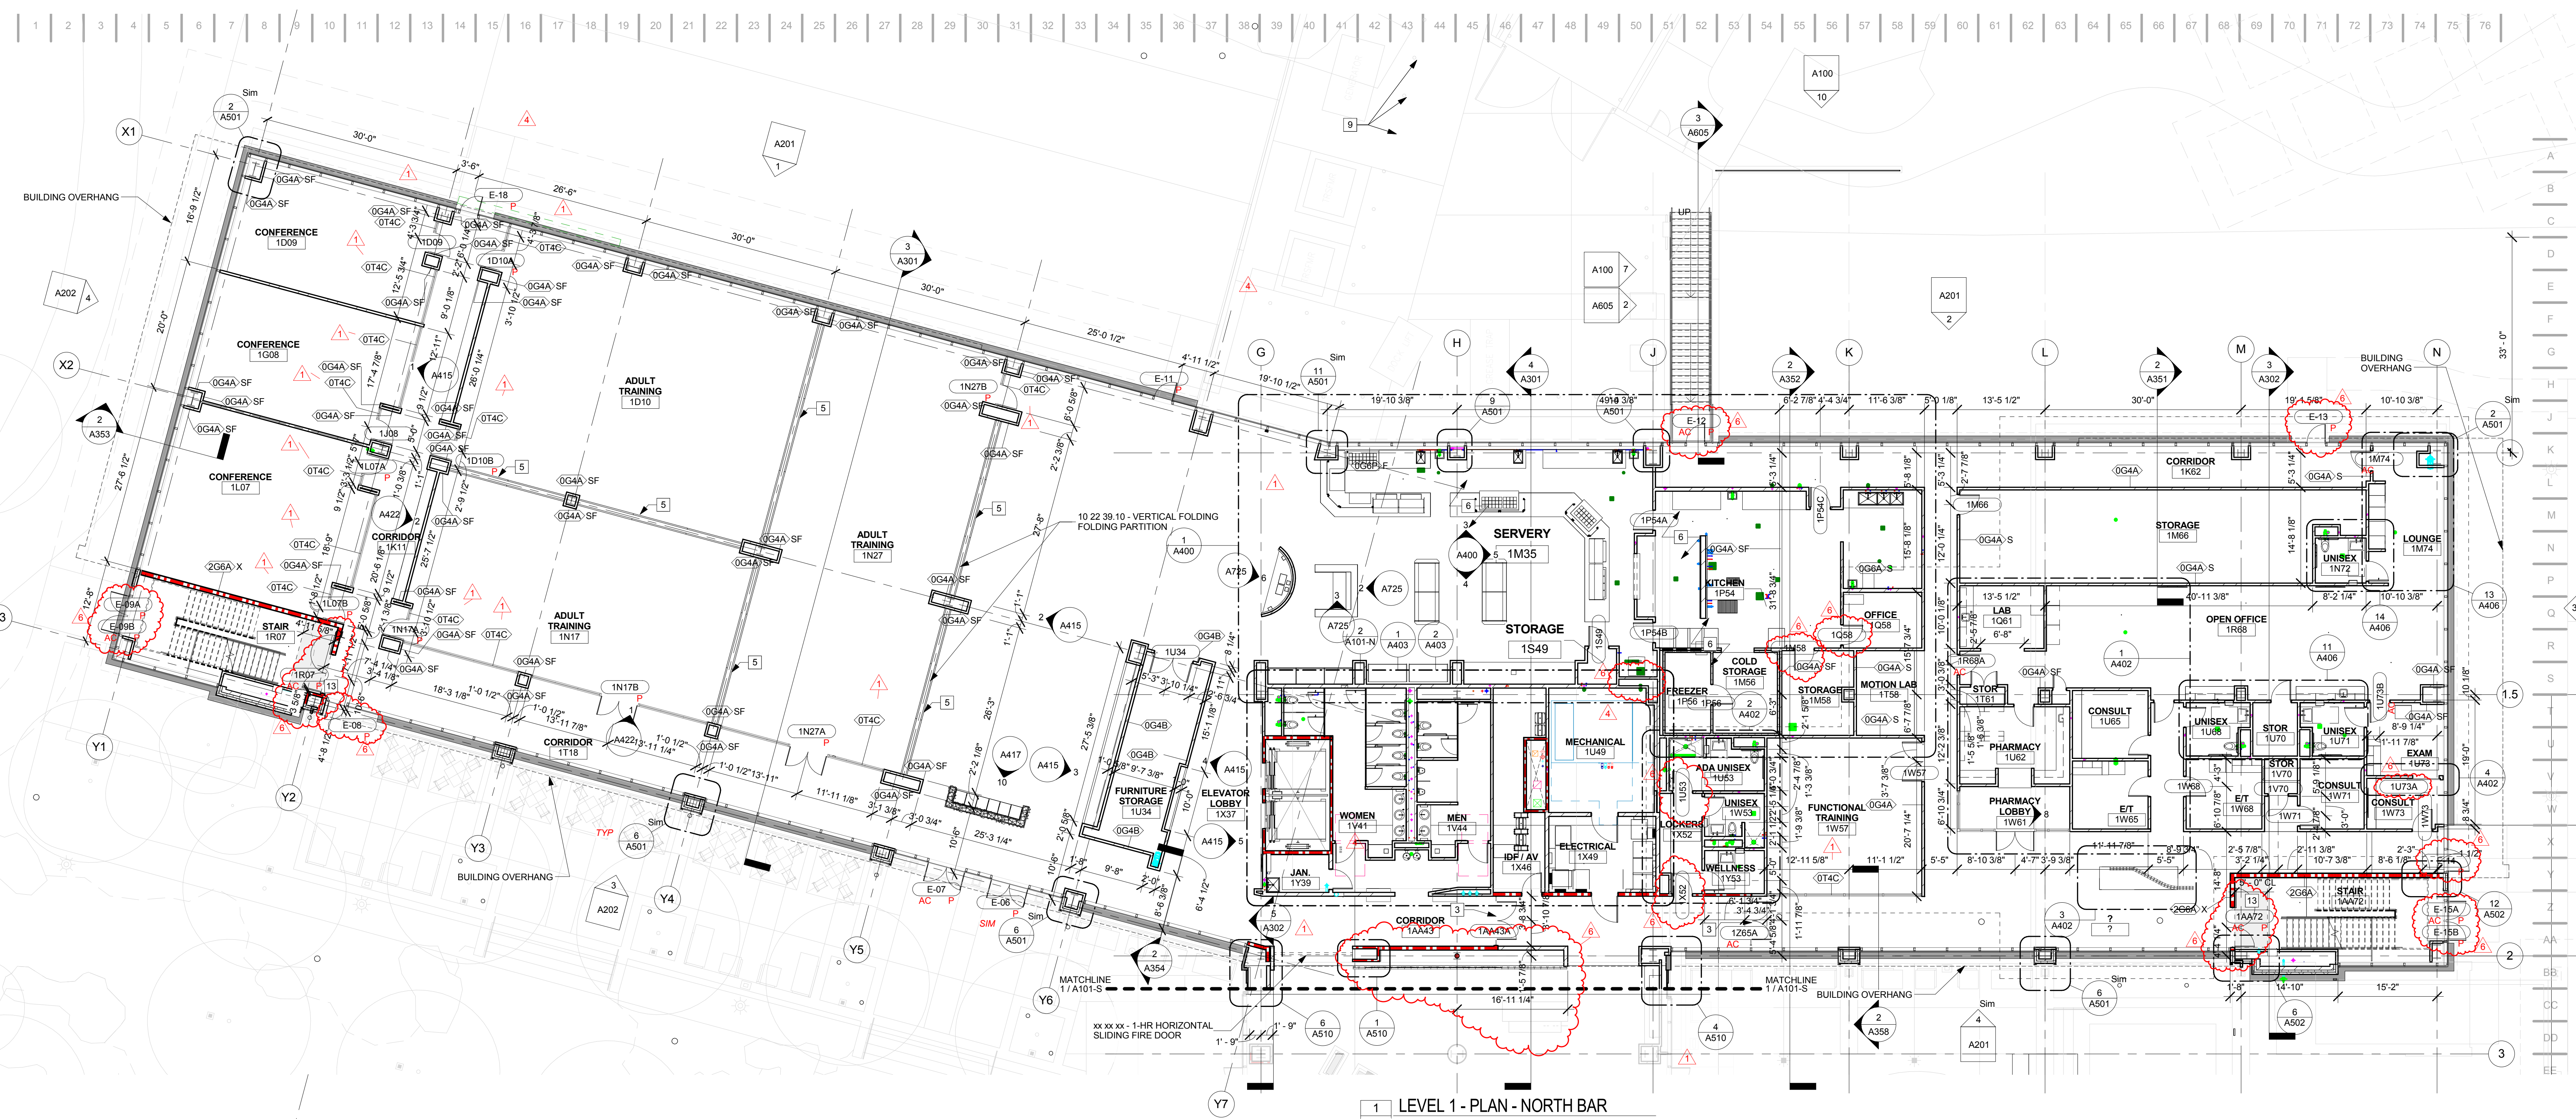

FLOOR PLAN - GENERAL NOTES

1. ALL LINEAR PARTITIONS TO BE 0G4A UN.O. SEE SHEET A020 FOR PARTITION TYPES.
2. ALL "BOX-OUT" NON-ROOM BOUNDING WALLS TO BE 0G4B UN.O. SEE SHEET A020 FOR PARTITION TYPES.
3. WORK NOTED "BY OTHERS" OR "NIC" SHALL BE PROVIDED BY OWNER OR UNDER SEPARATE CONTRACT.
4. SEE SHEET A030 FOR DOOR TYPES AND DETAILS.
5. PROVIDE CONTROL JOINTS ON GYP. BD. ASSEMBLIES PER SPECIFICATIONS AND WHERE SHOWN.
6. EXTEND WALLS TO DECK ABOVE STOREFRONT SYSTEMS AND GLASS WALL PARTITIONS.
7. REVIEW DOCUMENTS AND VERIFY DIMENSIONS AND FIELD CONDITIONS WHEN APPLICABLE. CONFIRM THAT WORK IS BUILDABLE AS SHOWN. ANY CONFLICTS OR OMISSIONS SHALL BE IMMEDIATELY REPORTED TO THE ARCHITECT FOR CLARIFICATION PRIOR TO THE PERFORMANCE OF WORK IN QUESTIONS.
8. COORDINATE AND PROVIDE METAL OR RATED SOLID WOOD BLOCKING (FIRE TREATED) IN PARTITIONS AND CEILING FOR MILLWORK, WALL AND CEILING ATTACHED ITEMS AS SPECIFIED.
9. DO NOT SCALE DRAWINGS. WRITTEN DIMENSIONS GOVERN. ALL PARTITION LOCATIONS, DIMENSIONS AND TYPES, DOOR AND WINDOW LOCATIONS SHALL BE AS SHOWN ON PARTITION PLAN. IN CASE OF CONFLICT, NOTIFY ARCHITECT.
10. COORDINATE WITH TENANT AND OWNER, THE SCHEDULE FOR TELEPHONE, DATA, SECURITY AND AUDIO VISUAL INSTALLATIONS.
11. PARTITIONS AT BUILDING PERIMETER SHALL BE CENTERED ON CENTER LINE OF COLUMN OR WINDOW MULLION, UNLESS OTHERWISE NOTED.
12. PROVIDE PARTITION TYPE WITH THE HIGHEST UL AND/OR ACUSTICAL PERFORMANCE RATING WHERE MORE THAN ONE PARTITION TYPE IS INDICATED. PARTITIONS SHALL BE TYPE "X" UNLESS OTHERWISE NOTED.
13. OFFSET ELECTRICAL AND TELEPHONE OUTLETS 16" MINIMUM IN SEPARATE STUD WALL CAVITIES.
14. PER DIRECTION FROM THE CITY OF ROSEVILLE, THESE PLANS HAVE BEEN REVIEWED FOR CONFORMANCE WITH 2013 CALIFORNIA BUILDING STANDARDS CODE.
15. PER REQUEST FROM THE CITY OF ROSEVILLE, THE SQUARE FOOTAGE OF DEDICATED MEDICAL USE SPACE IS 1,704 SF WHICH INCLUDES: FUNCTIONAL TRAINING 1W57, MOTION LAB 1T58, PHARMACY LOBBY 1W61, PHARMACY 1W62, LAB 1G61, CONSULT 1U65, 1W71, 1W73, ET 1W65, 1W68, EXAM 1U73


INTERIOR DEMOUNTABLES:

- GLASS DEMOUNTABLE PARTITION
 - SOLID DEMOUNTABLE PARTITION
- SEE DEMOUNTABLE NARRATIVE FOR ADDITIONAL INFORMATION


FLOOR PLAN - KEYED NOTES

1. FIRE EXTINGUISHER & CABINET AT THIS LOCATION. PROVIDE REQUIRED QUANTITY ON EACH FLOOR PER CODE AND/OR AHJ. SEE A020 FOR TYP. INSTALLATION DETAILS AND REFER TO LIFE SAFETY PLANS FOR ALL EXTINGUISHER LOCATIONS.
2. BRACKET MOUNTED FIRE EXTINGUISHER AT THIS LOCATION. PROVIDE REQUIRED QUANTITY ON EACH FLOOR PER CODE AND/OR AHJ. SEE A020 FOR TYP. INSTALLATION DETAILS AND REFER TO LIFE SAFETY PLANS FOR ALL EXTINGUISHER LOCATIONS.
3. 1 HR FIRE RATING THROUGH INCLUSION OF FIRE SPRINKLER ON GLAZED PARTITIONS
4. CEILING HEIGHT CHAIN LINK FENCE SECURITY PANELS TYP. IN STAGING - COORD W/ RCP.
5. VERTICAL FOLDING PARTITION.
6. SERVERY & KITCHEN LAYOUT IN PROGRESS.
7. PRE-CAST CONCRETE STILL WATER FEATURE W/ REMOTE PUMP FOR RECIRCULATION. SEE A402. FORM TO HAVE RECESSED BASE AND RECESSED INTERIOR SIDE WALLS AT POOL.
8. LOCATE BOARDROOM DOORS SUCH THAT FRAME ALIGNS WITH TRANSITION AT FLOOR TILE AND CARPET. TERMINATE FLOOR TILE PATTERN AT FULL TILE MODULE - SEE FINISH PLAN.
9. REMOVABLE PIPE BOLLARD.
10. MODULAR CASEGOODS BY HAMILTON SORTER TO INCLUDE MAIL SORTERS, COUNTERS, AND CABINETS. BASE WALL CABINETS TO INCLUDE 30% DRAWER STACKS AND 70% DOUBLE DOORS WITH INTERIOR ADJUSTABLE SHELVES AND ONE ROW OF DRAWERS. ISLAND BASE CABINET WITH DOORS AND INTERIOR ADJUSTABLE SHELVES. UPPER WALL CABINETS TO INCLUDE RECONFIGURABLE MAIL SORTERS AND DOUBLE DOORS WITH INTERIOR SHELVES. PREMIUM GRADE PLASTIC LAMINATE EXTERIOR AND MELAMINE INTERIOR FINISH. TYP. ALL COUNTERTOPS TO BE 2'-0" AFF. LOWEST SHELF OF UPPER CABINETS TO BE WITHIN 48" MAX. REACH RANGE.
11. HORIZONTAL FOLDING PARTITION.
12. PROVIDE WALL MOUNTED MAXIMUM OCCUPANCY SIGN ADJACENT TO WALL SWITCHES. SIGN SHALL READ A MAXIMUM OCCUPANCY OF 99 PEOPLE. REFER TO SHEET A030 FOR FURTHER SIGNAGE INFORMATION.
13. DOOR DISTANCE FROM WALL TO BE COORDINATED WITH DOOR HOLD OPEN HARDWARE - 3'-5 5/8" DISTANCE COORDINATED WITH RUXSON 999 ELECTROMAGNETIC DOOR HOLDER.
14. FURR WALL W/ 3'-5 5/8" STUD AND THEN W/ 2'-11/2" STUD TO PROVIDE ARE FOR RECESSED TELEVISION. SEE 12 | A425

RATED WALL LEGEND

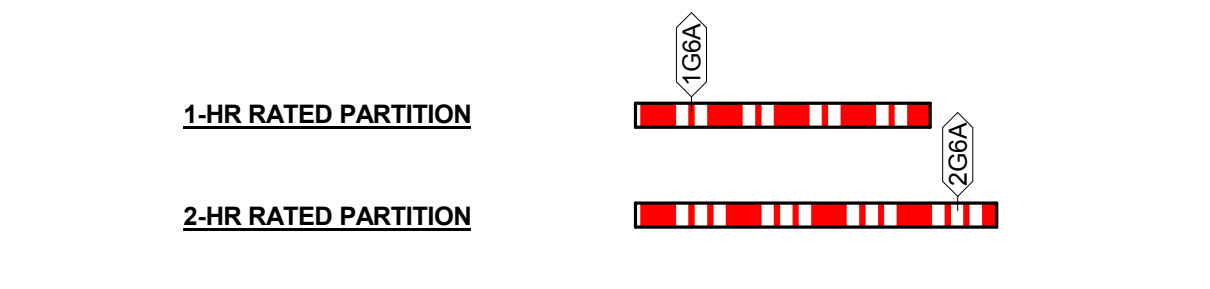


KEY PLAN

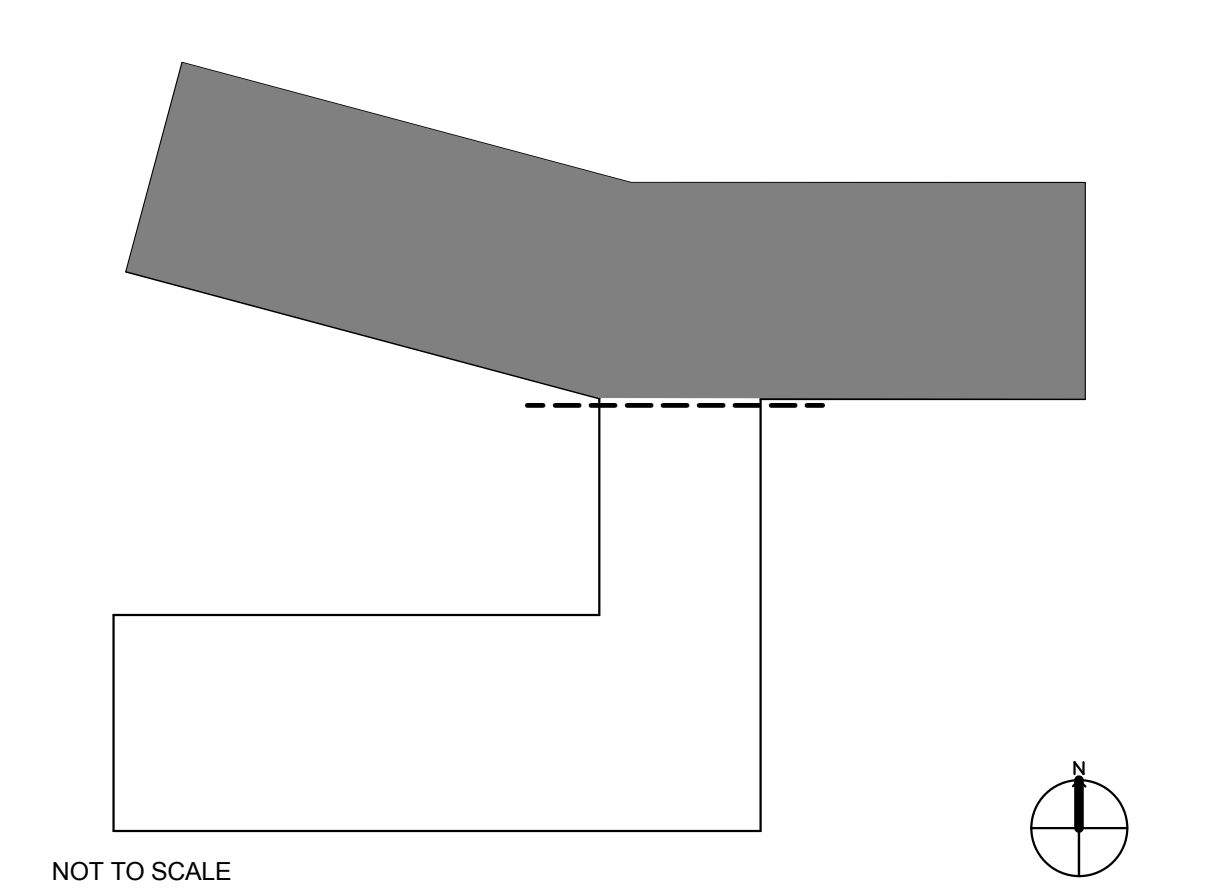

2 ENLARGED CORE - LEVEL 01 NORTH
A101-N 3/16" = 1'-0"

1 LEVEL 1 - PLAN - NORTH BAR
A101-N 3/32" = 1'-0"

NOT TO SCALE

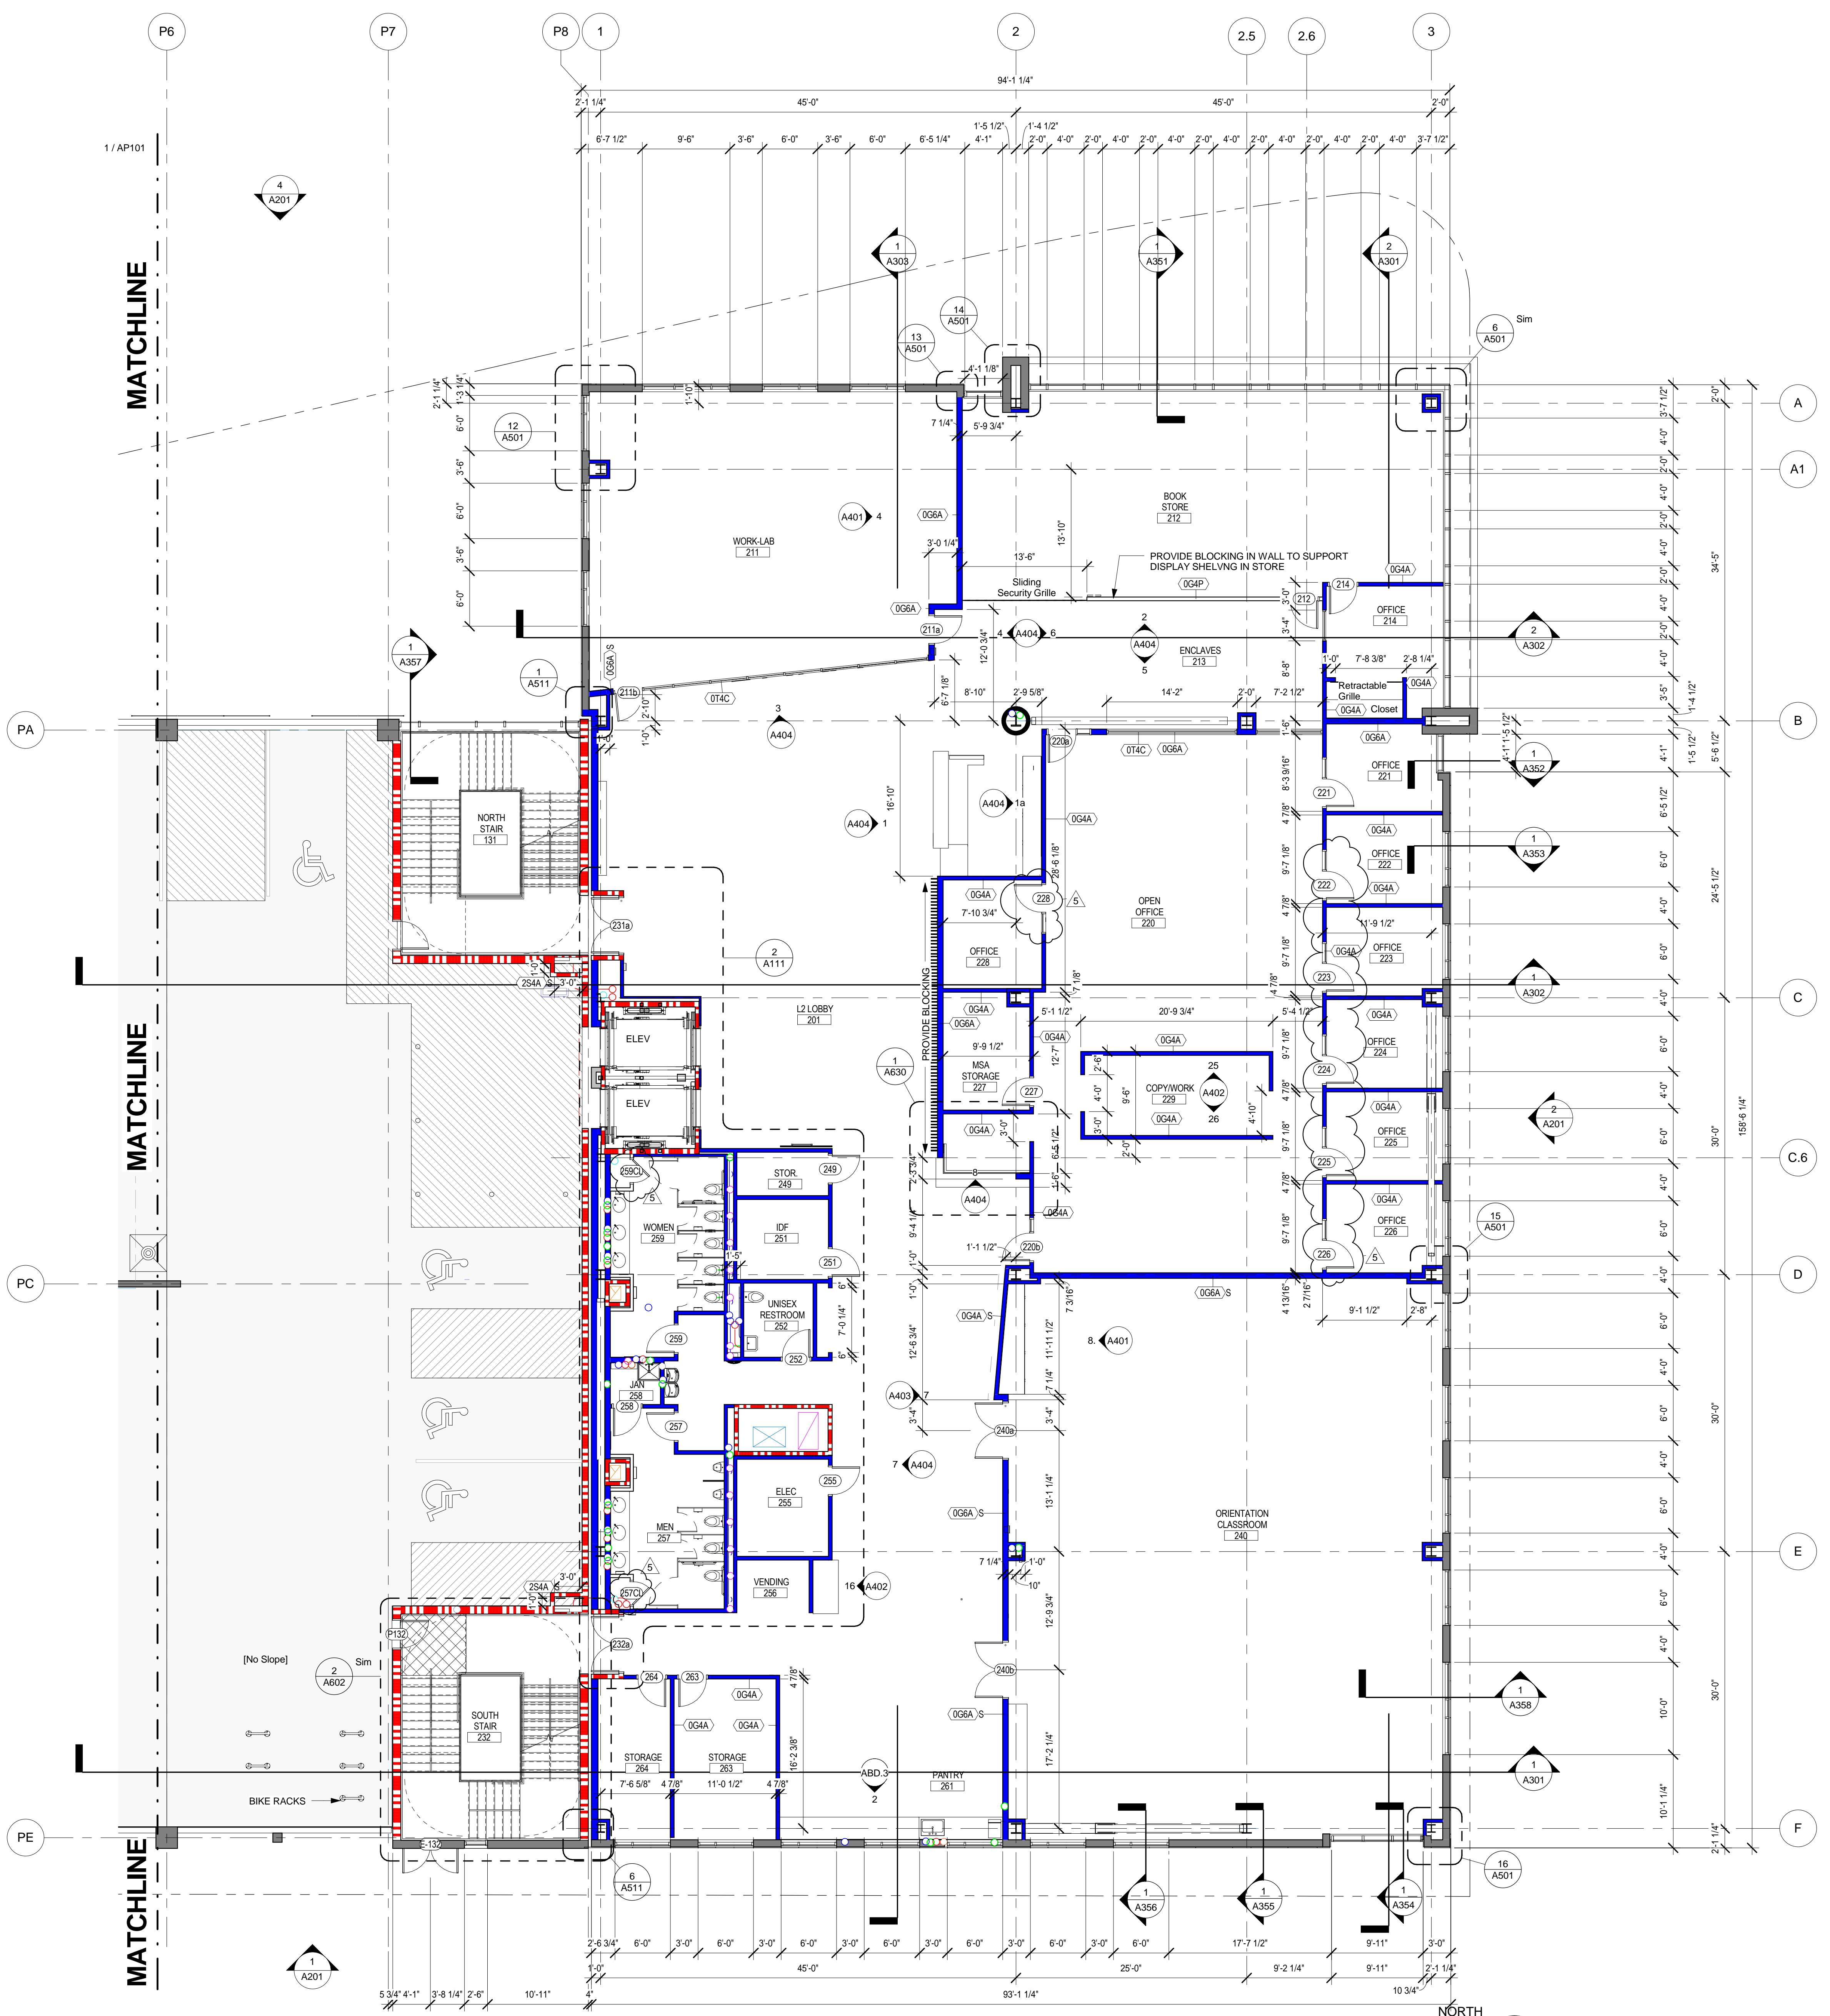

1 OFFICE LEVEL 2
A102 1/8" = 1'-0"


FLOOR PLAN - GENERAL NOTES

- WORK NOTED BY OTHERS OR "N/C" SHALL BE PROVIDED BY OWNER OR UNDER SEPARATE CONTRACT
- SEE SHEET A200 FOR PARTITION TYPES
- SEE SHEET A201 FOR DOOR TYPES AND DETAILS
- PROVIDE CONTROL JOINTS ON GYP. BD. ASSEMBLES PER SPECIFICATIONS AND WHERE SHOWN
- EXTEND WALLS TO DECK ABOVE STOREFRONT SYSTEMS AND GLASS WALL PARTITIONS
- REVIEW DOCUMENTS AND VERIFY DIMENSIONS AND FIELD CONDITIONS WHEN APPLICABLE. CONFIRM THAT WORK IS BUILDABLE AS SHOWN. ANY CONFLICTS OR OMISSIONS SHALL BE IMMEDIATELY REPORTED TO THE ARCHITECT FOR CLARIFICATION PRIOR TO THE PERFORMANCE OF WORK IN QUESTIONS
- COORDINATE AND PROVIDE METAL OR RATED SOLID WOOD BLOCKING FIRE TREATED IN PARTITIONS AND CEILING FOR MILLWORK, WALL AND CEILING ATTACHED ITEMS AS SPECIFIED. DO NOT SCALE DRAWINGS. WRITTEN DIMENSIONS GOVERN. ALL PARTITION LOCATIONS, DIMENSIONS AND TYPES, DOOR AND WINDOW LOCATIONS SHALL BE AS SHOWN ON PARTITION PLAN. IN CASE OF CONFLICT, NOTIFY ARCHITECT
- COORDINATE WITH TENANT AND OWNER, THE SCHEDULE FOR TELEPHONE, DATA, SECURITY AND AUDIO VISUAL INSTALLATIONS. PARTITIONS AT BUILDING PERIMETER SHALL BE CENTERED ON CENTER LINE OF COLUMN OR WINDOW MULLION, UNLESS OTHERWISE NOTED
- PROVIDE PARTITION TYPE WITH THE HIGHEST UL AND/OR ACOUSTICAL PERFORMANCE RATING WHERE MORE THAN ONE PARTITION TYPE IS INDICATED. PARTITIONS SHALL BE HEAD CONDITION 'A' UNLESS OTHERWISE NOTED
- OFFSET ELECTRICAL AND TELEPHONE OUTLETS 16" MINIMUM IN SEPARATE STUD WALL CAVITIES
- PROVIDE ACOUSTIC SOUNDS BATS ABOVE ALL DEMOUNTABLE PARTITION WALLS. EXTEND 3'-0" BOTH SIDES OF PARTITION.

MILLWORK - GENERAL NOTES

- ALL CABINET WORK SHALL BE DONE IN ACCORDANCE WITH ARCHITECTURAL WOODWORK STANDARDS FOR CUSTOM GRADE.
- CABINET CONTRACTOR SHALL VERIFY ALL DIMENSIONS IN THE FIELD FOR BUILT-IN WORK PRIOR TO FABRICATION
- CABINET CONTRACTOR SHALL COORDINATE ALL NECESSARY WOOD BLOCKING IN CONJUNCTION WITH HIS WORK INCLUDING BLOCKING REQUIRED FOR THE INSTALLATION OF ANY PREFABRICATED CABINETS
- ALL WOODWORKING AND BLOCKING ATTACHED TO THE PREMISES SHALL BE FIRE RETARDANT IN ACCORDANCE WITH LOCAL BUILDING CODES
- ALL SURFACES THAT ARE TO RECEIVE PLASTIC LAMINATE FINISHES SHALL ALSO HAVE FINISHED MATERIALS ON ALL EXPOSED EDGES, WHERE APPLICABLE, TO PROVIDE A "BALANCED" CONSTRUCTION
- CONTRACTOR SHALL SUBMIT SHOP DRAWINGS FOR LITTLE'S REVIEW IN ACCORDANCE WITH GENERAL CONDITIONS OF THIS PROJECT.
- PLASTIC LAMINATE SHALL BE ONE SINGLE SHEET PREMIUM GRADE ON ANY SURFACE. SEAMS, IF REQUIRED, SHALL BE INDICATED ON SHOP DRAWINGS. SEAMS NOT INDICATED ON SHOP DRAWINGS AND FOUND TO BE UNACCEPTABLE SHALL BE CORRECTED AT COST TO MILLWORK CONTRACTOR.
- COORDINATION OF MILLWORK WITH EXISTING AND NEW CONSTRUCTION AND WITH MECHANICAL, FURNITURE OR RELATED ELEMENTS SHALL BE THE RESPONSIBILITY OF THE GENERAL CONTRACTOR.
- CABINET HARDWARE TO BE DESIGNER SELECTED, AS FOLLOWS:
(a) CASEWORK PULLS TO BE HAFELE #106.74.904, #106.74.917, #106.74.929 - NOT SHOWN YET OR OTHERWISE
(b) DRAWER GLIDES TO BE ACCURIDE FULL EXTENSION HEAVY DUTY WITH SOFT CLOSE.
- SEE FINISH PLANS FOR MILLWORK DESCRIPTIONS
- ALL PLAM COUNTER TOPS WITH OPENINGS FOR ACCESS TO TRASH BELOW TO RECEIVE ALUM TRIM PER MOCKET. EXACT SIZES TBD / SEE FINISH PLAN FOR LOCATIONS
- ALL SS COUNTER TOPS WITH OPENING FOR ACCESS TO TRASH BELOW TO HAVE FINISHED SS EDGE / EXACT SHAPE & SIZE TBD / SEE FINISH PLAN FOR LOCATIONS
- SEE TA DRAWINGS FOR BLOCKING DETAILS AT RECESSED AV MONITORS

WALL RATING LEGEND

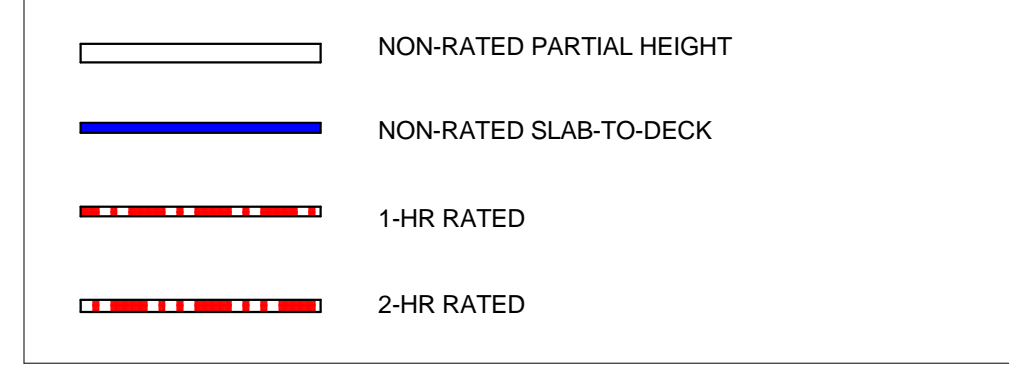

LITTLE
DIVERSIFIED ARCHITECTURAL CONSULTING

5815 Westpark Drive
Charlotte, NC 28217
770.262.4350

www.littleonline.com

This drawing and the design shown are the property of Little Diversified Architectural Consulting. The reproduction, copying or other use of this drawing without their written consent is prohibited and any infringement will be subject to legal action.

© Little 2017

Charlotte Regional Realtor Association

SELWYN
PROPERTY GROUP

CONSTRUCTION SERVICES SINCE 1993

Myers & Chapman
Your Building Partner

PAPPAS PROPERTIES

DIVERSIFIED ARCHITECTURAL CONSULTING
CERT. NO. 60033
NORTH CAROLINA
CHARLOTTE, NC

EDWARD LOUIS
REGISTERED ARCHITECT
NORTH CAROLINA
CHARLOTTE, N.C.
51018

ISSUE FOR CONSTRUCTION

ISSUE DATE: 11/13/17

NO.	REASON	DATE
1	Permit Review Comments	12/8/17
2	Addendum #6	01/26/18
3	Modification 1	05/10/18
4	RFI-45 & 47	08/31/18
5	Doors	08/22/18

PROJECT TEAM
PRINCIPAL IN CHARGE: EDDIE PORTIS, AIA
PROJECT MANAGER: TIM LOKEN, AIA


DESIGN TEAM
CHAIR: FDB, CC, JT


PROJECT NAME
CHARLOTTE REGIONAL REALTOR ASSOCIATION - NEW OFFICE
1120 PEARL PARK WAY
CHARLOTTE, NC 28204

PROJECT NO.
132.6273.00


SHEET TITLE
FLOOR PLAN - LEVEL 2

SHEET NUMBER
A102

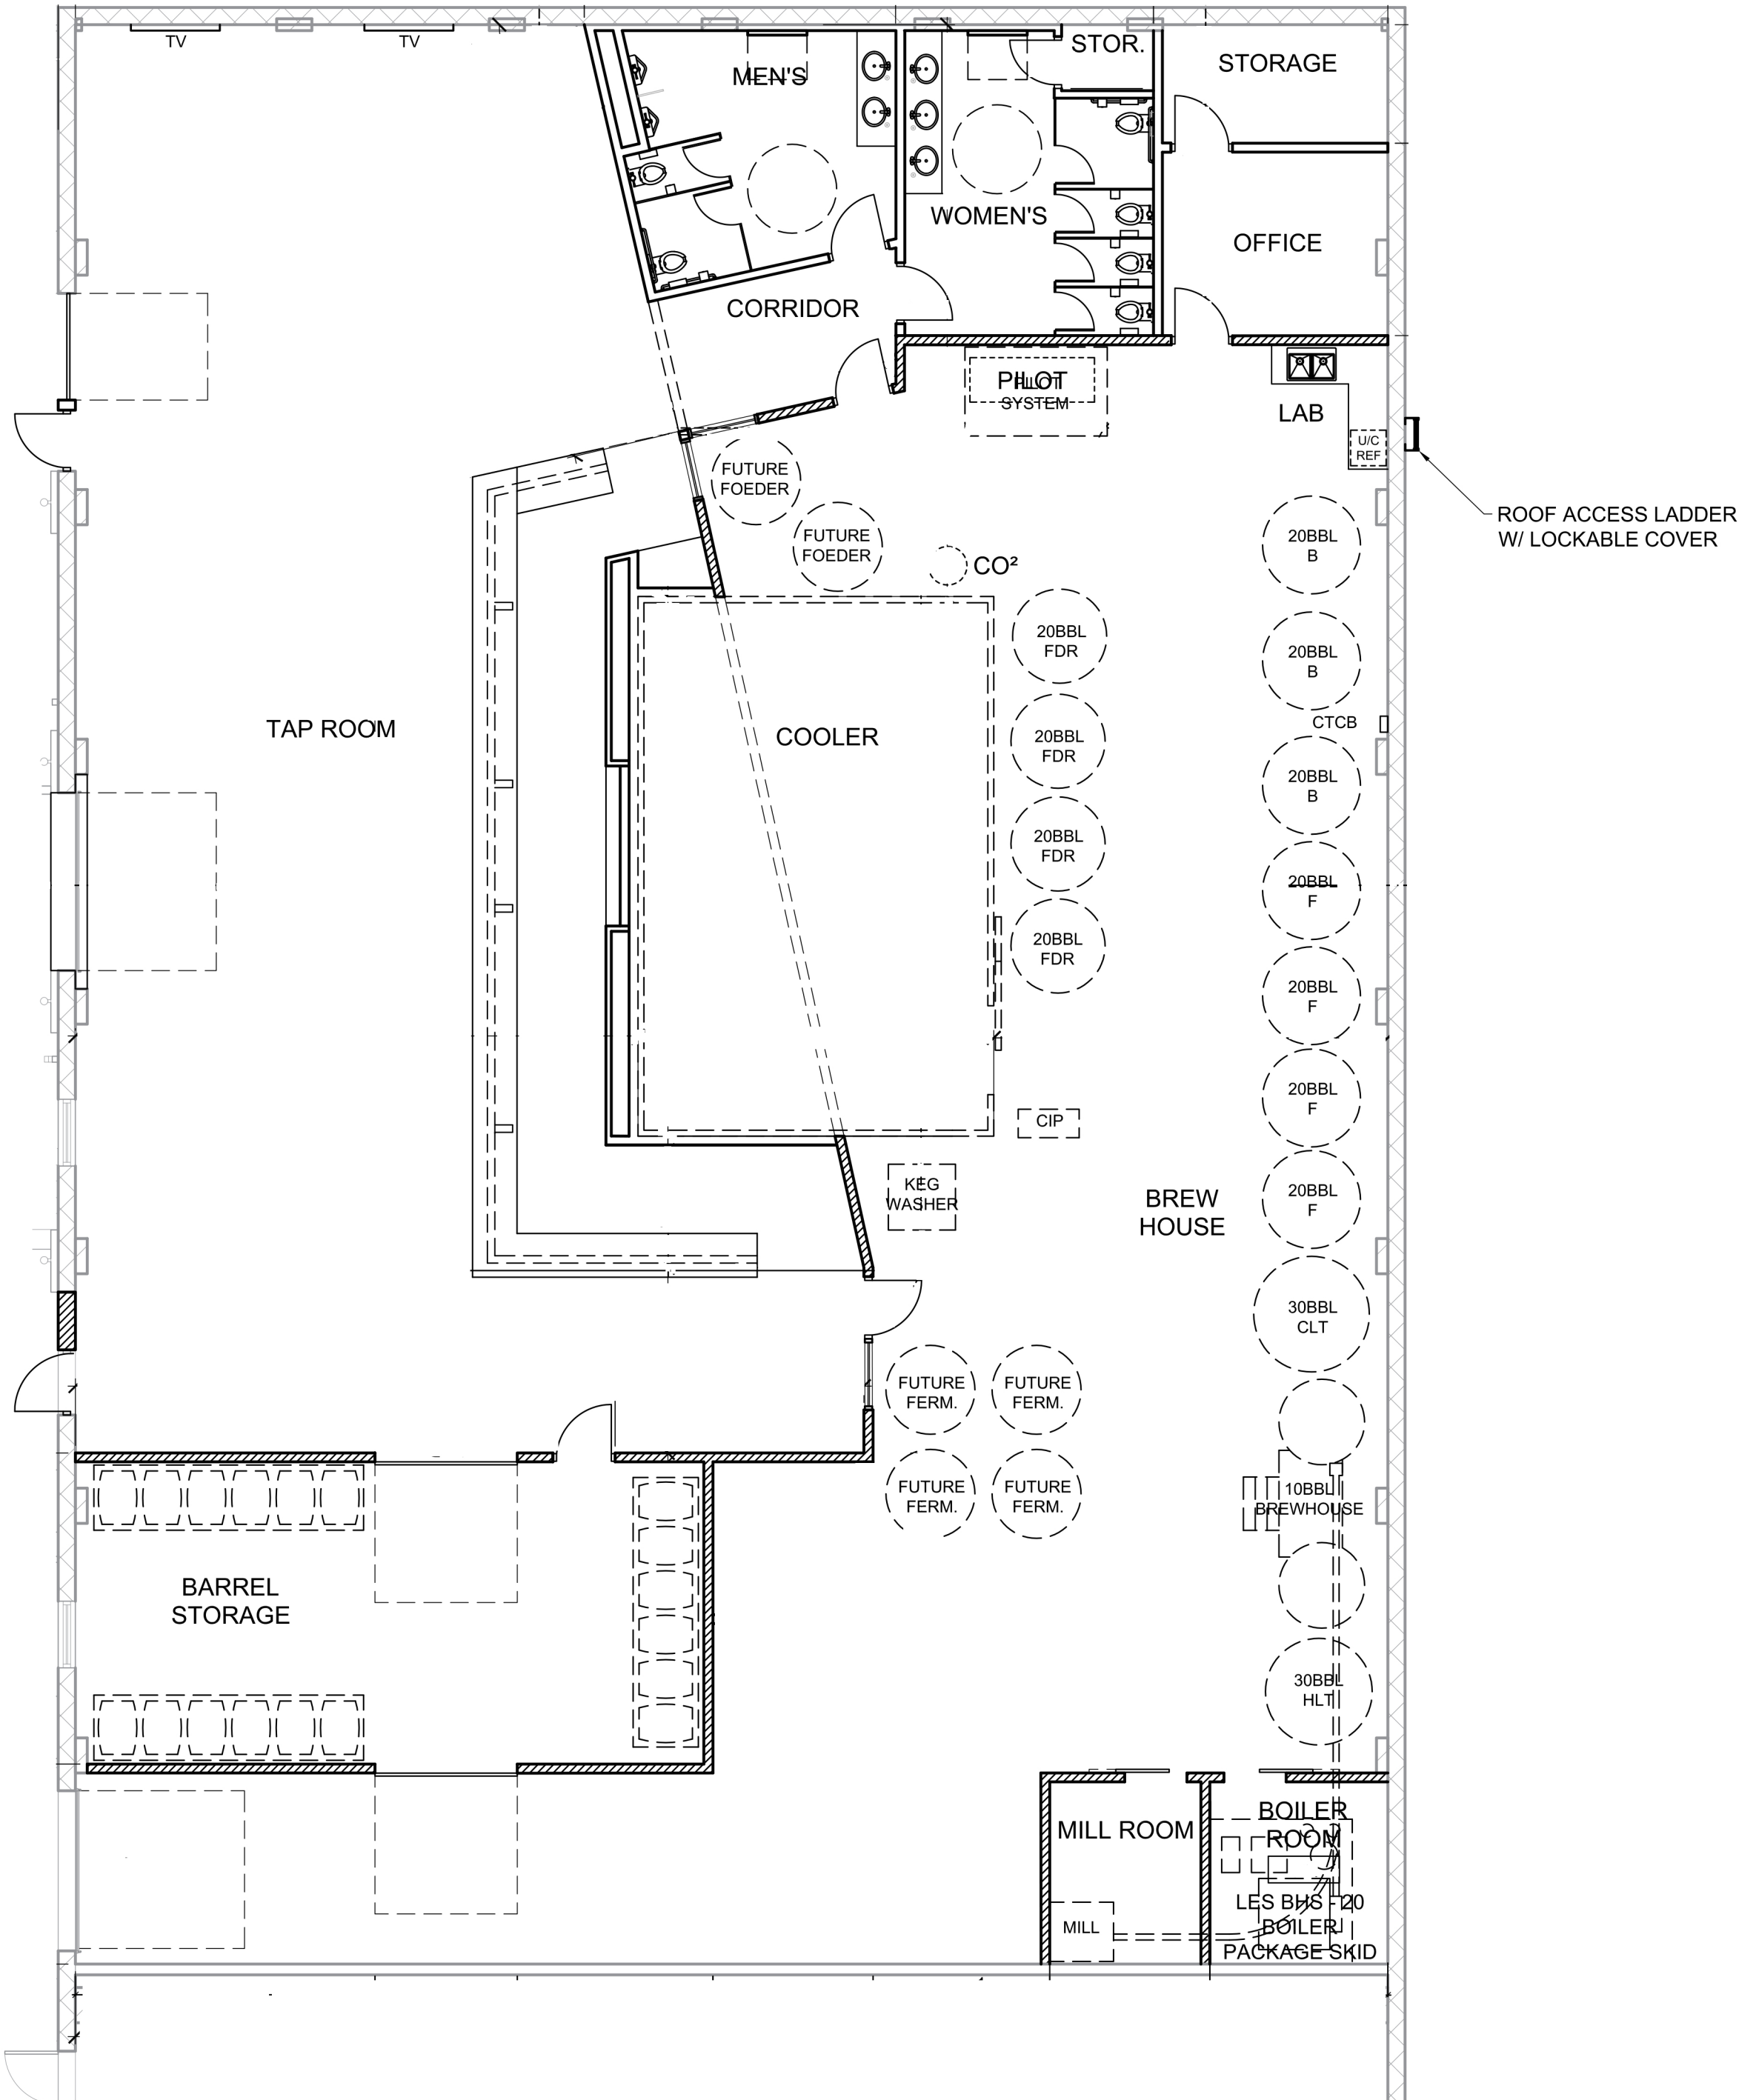

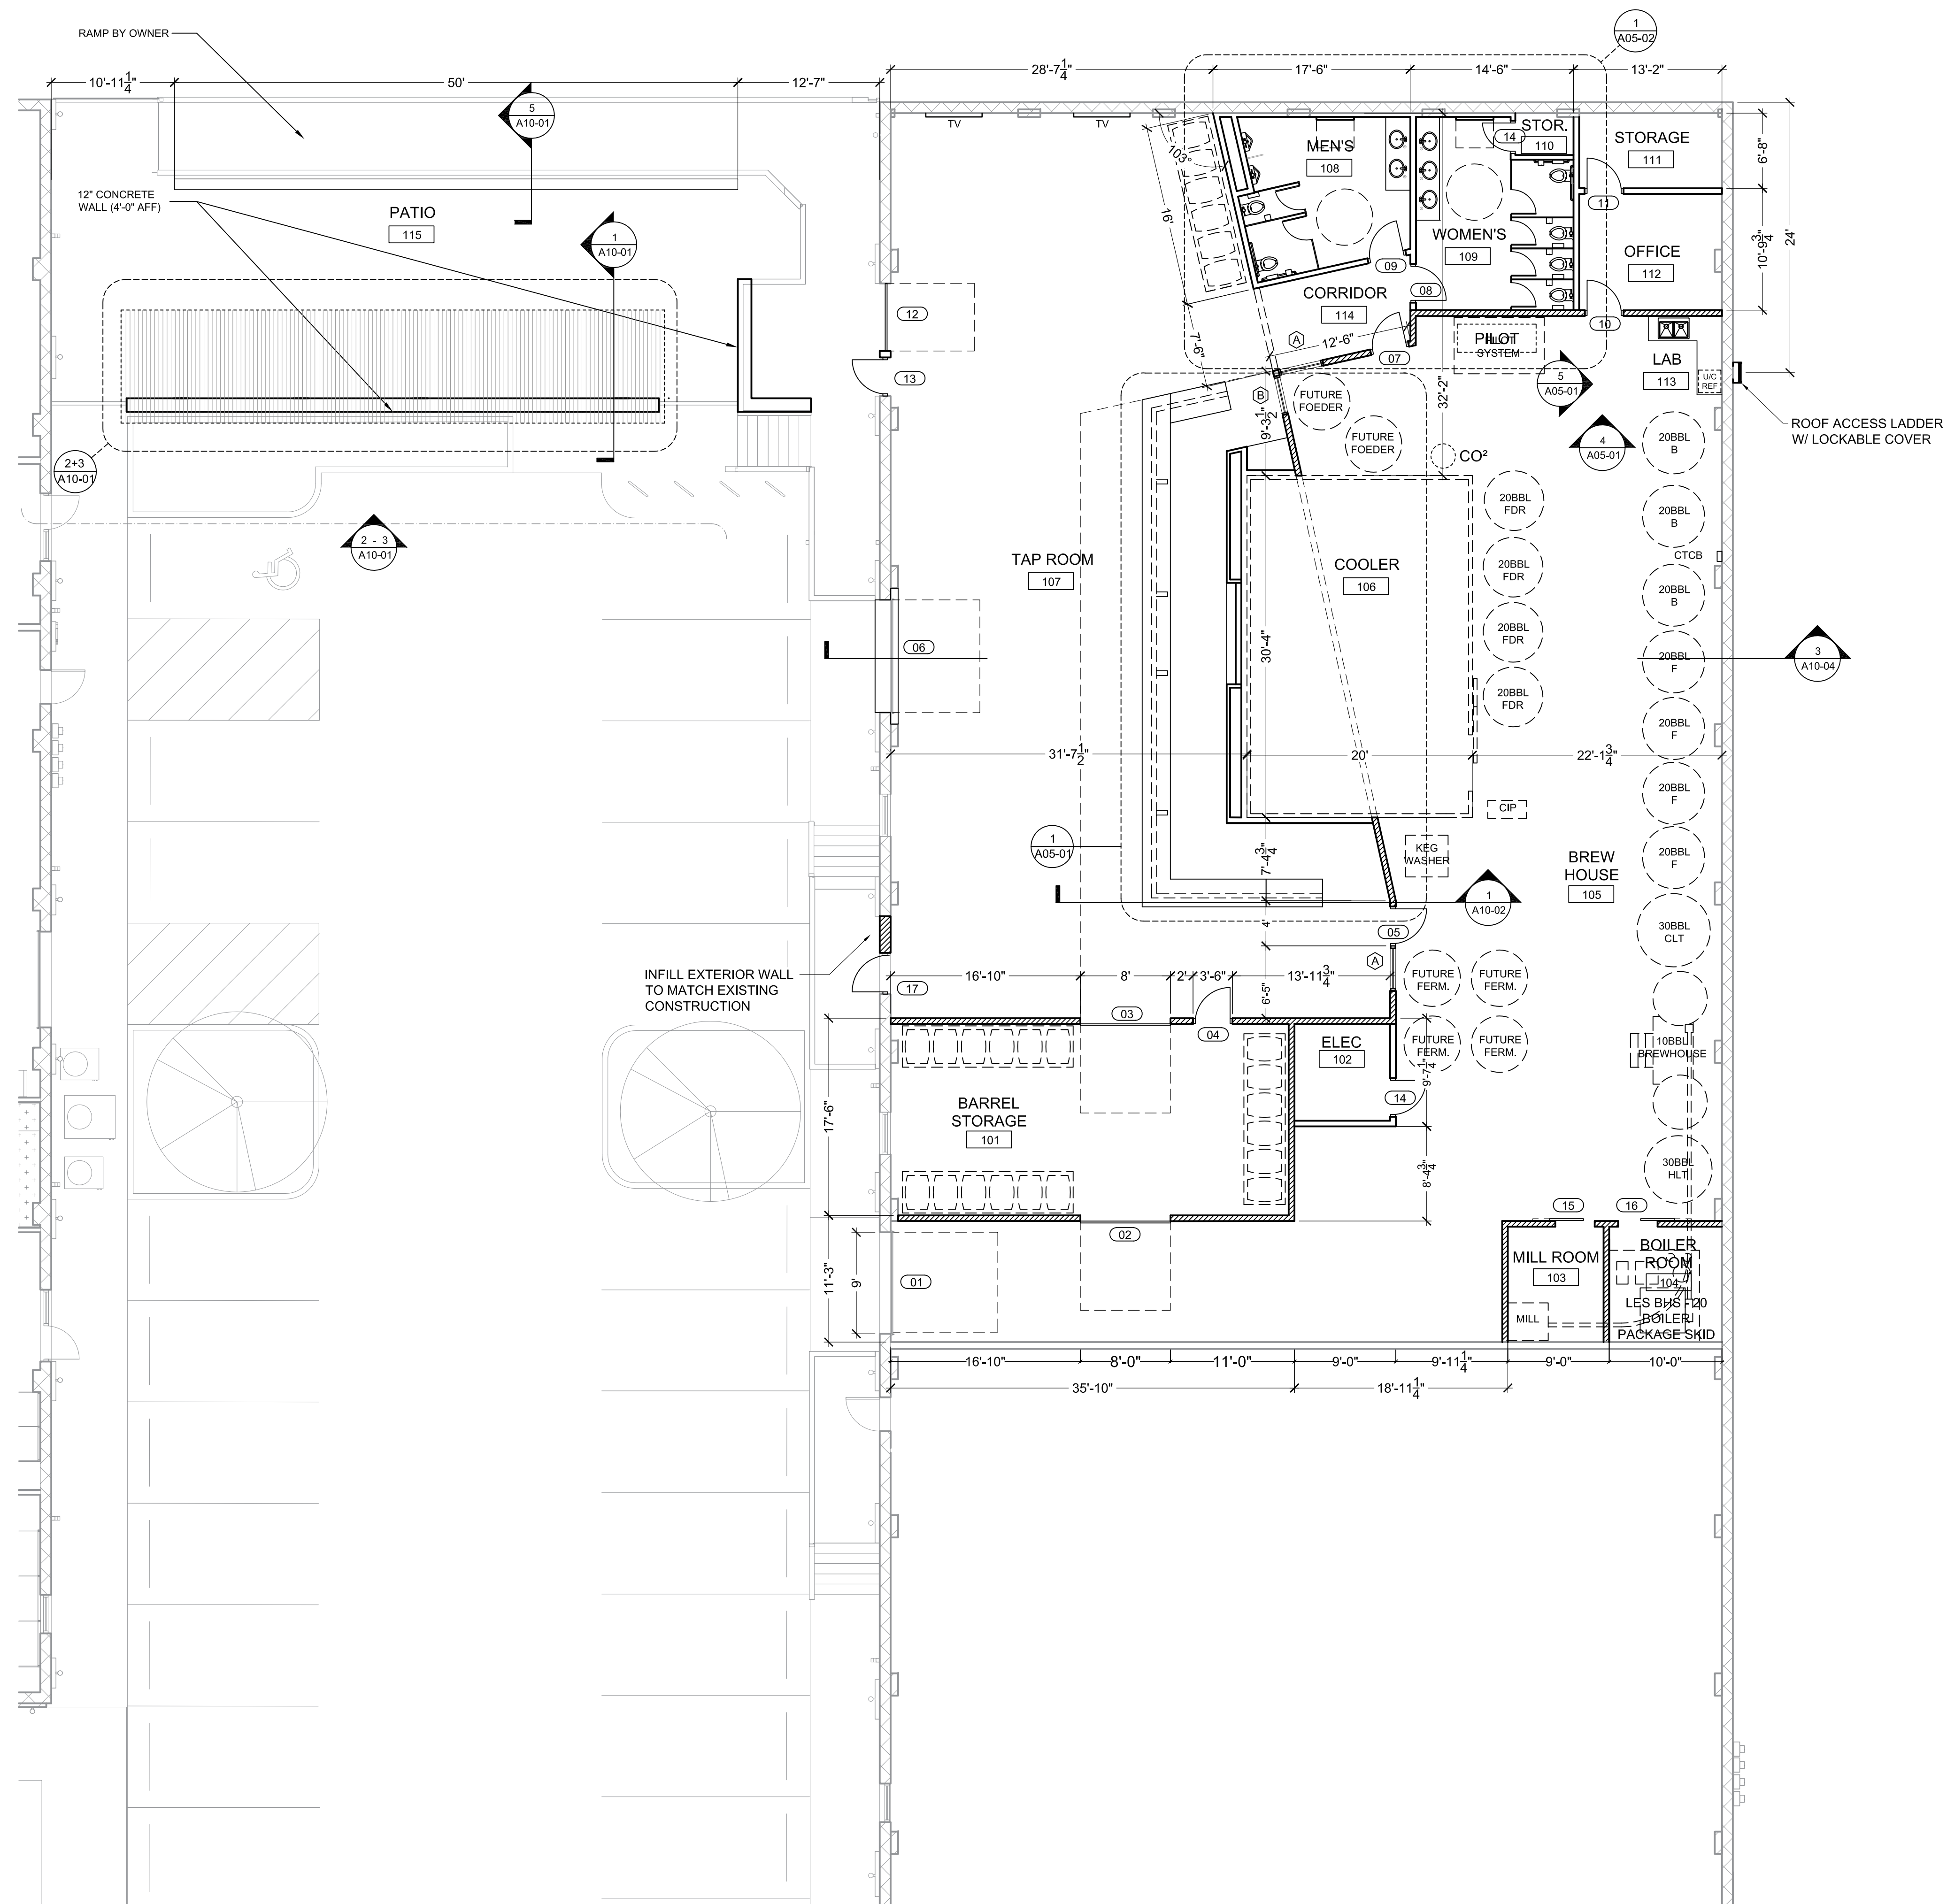


- FLOOR PLAN GENERAL NOTES**
1. ALL TAP ROOM FURNITURE OFOI - SHOWN FOR REPRESENTATION ONLY.
 2. ALL BREWING EQUIPMENT AND BARREL STORAGE RACKS (INCLUDING COOLER) TO BE PROVIDED/INSTALLED BY OWNER.
 3. WALLS EXTENDING TO DECK (SHOWN SHADED) TO BE 6" MTL STUDS WITH 5/8" GWB EACH SIDE. ALL OTHER WALLS TO BE 3 5/8" MTL STUDS WITH 5/8" GWB EACH SIDE, TYP.
 4. ALL FLOOR DRAINS TO BE LOCATED PER A01-01
 5. ALL ROOF PENETRATIONS TO BE A MINIMUM OF 4'-0" FROM EDGE OF ROOF.
 6. ALL DOORS TO BE LOCATED MIN. 4" FROM INTERIOR SWING WALL U.N.O.

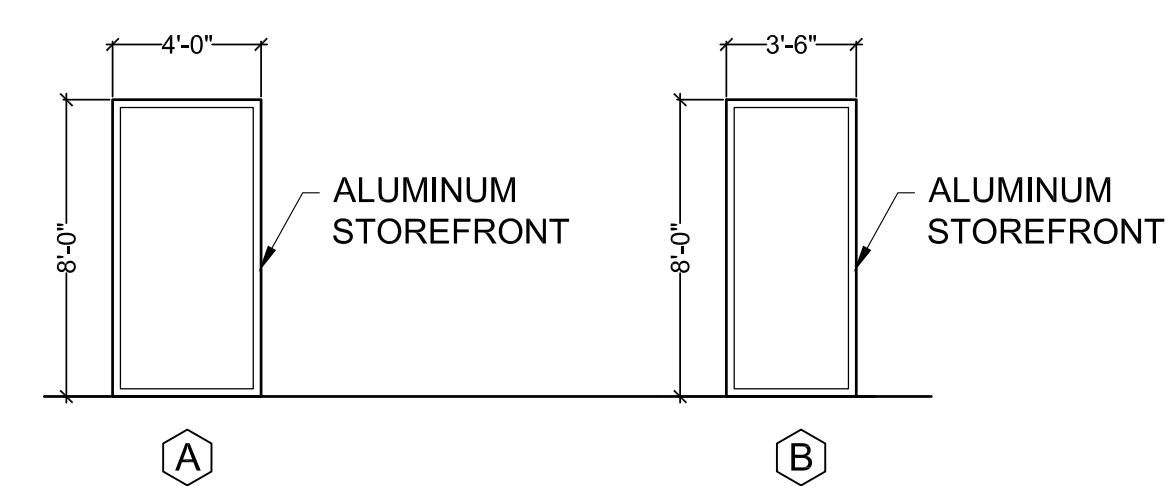

3 GLAZING TYPES

DOOR SCHEDULE						
#	WIDTH	HEIGHT	TYPE	FRAME	FINISH	NOTES
01	9'-0"	9'-0"	EXISTING	---	---	
02	8'-0"	8'-0"	B - STEEL OVHD ROLL-UP DOOR	---	PT	
03	8'-0"	8'-0"	B - STEEL OVHD ROLL-UP DOOR	---	PT	
04	3'-0"	8'-0"	A - FLUSH WOOD DOOR	HM	STD WD	
05	3'-0"	8'-0"	A - FLUSH WOOD DOOR	HM	STD WD	DOOR TO HAVE CHEMICAL RESISTANT WATERPROOF SWEEP
06	10'-0"	5'-0"	EXISTING	---	---	
07	3'-0"	8'-0"	A - FLUSH WOOD DOOR	HM	STD WD	DOOR TO HAVE CHEMICAL RESISTANT WATERPROOF SWEEP
08	3'-0"	8'-0"	A - FLUSH WOOD DOOR	HM	STD WD	
09	3'-0"	8'-0"	A - FLUSH WOOD DOOR	HM	STD WD	
10	3'-0"	8'-0"	A - FLUSH WOOD DOOR	HM	STD WD	DOOR TO HAVE CHEMICAL RESISTANT WATERPROOF SWEEP
11	3'-0"	8'-0"	A - FLUSH WOOD DOOR	HM	STD WD	
12	6'-0"	7'-0"	C - GLAZED ROLL-UP DOOR	---	---	
13	3'-0"	7'-0"	D - GLAZED STOREFRONT DOOR	---	---	EMERGENCY EGRESS HARDWARE, CLOSER
14	2'-6"	8'-0"	E - FLUSH STEEL DOOR	HM	PT	60 MIN RATED, EMERGENCY EGRESS HARDWARE, CLOSER
15	3'-0"	8'-0"	A - FLUSH WOOD DOOR	HM	STD WD	SURFACE MOUNTED
16	3'-0"	8'-0"	A - FLUSH WOOD DOOR	HM	STD WD	SURFACE MOUNTED
17	3'-0"	8'-0"	E - FLUSH STEEL DOOR	HM	PT	45 MIN RATED, EMERGENCY EGRESS HARDWARE, CLOSER

1. ALL DOORS TO HAVE FLOOR MOUNTED STOPS PROVIDED AND POSITIONED TO PREVENT COLLISION WITH WALLS SURFACES, EQUIPMENT ETC.

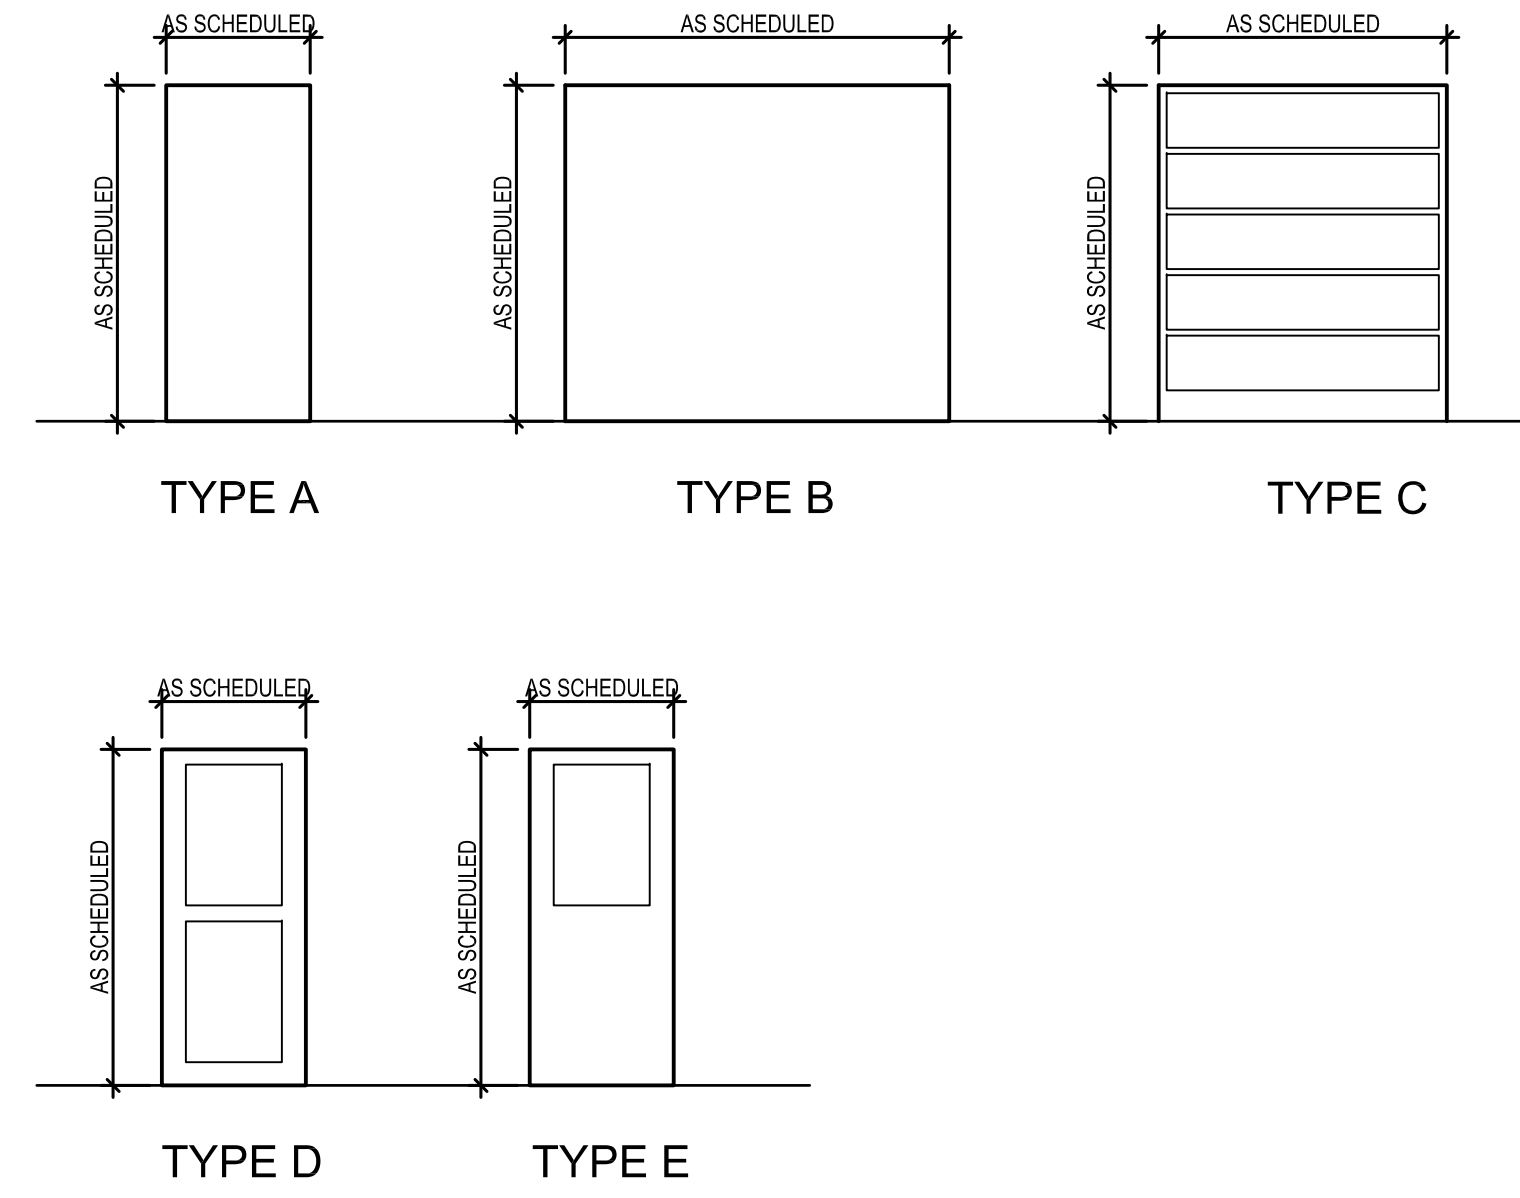

1 DOOR TYPES

2 FLOOR PLAN

SCALE: 1/8" = 1' - 0"

Architecture
NEAR DESIGN WORKSHOP
3537 Annlin Ave
Charlotte, NC 28209

Structural
Hunter Structural PA
1900 Abbott St #103
Charlotte, NC 28203

Mechanical
VP Engineering
1414-C South Tryon Street
Charlotte, NC 28203

Electrical
VP Engineering
1414-C South Tryon Street
Charlotte, NC 28203

Plumbing
VP Engineering
1414-C South Tryon Street
Charlotte, NC 28203

DIVINE BARREL BREWING
NODA STREET MARKET
3929-3701 N. DAVIDSON STREET
CHARLOTTE, NC 28205

STAMP

REVISIONS


#	TITLE	DATE

FLOOR PLAN
SHEET TITLE
A01-02
SHEET ID


NEAR DESIGN WORKSHOP



● COLLABORATIVE AREAS

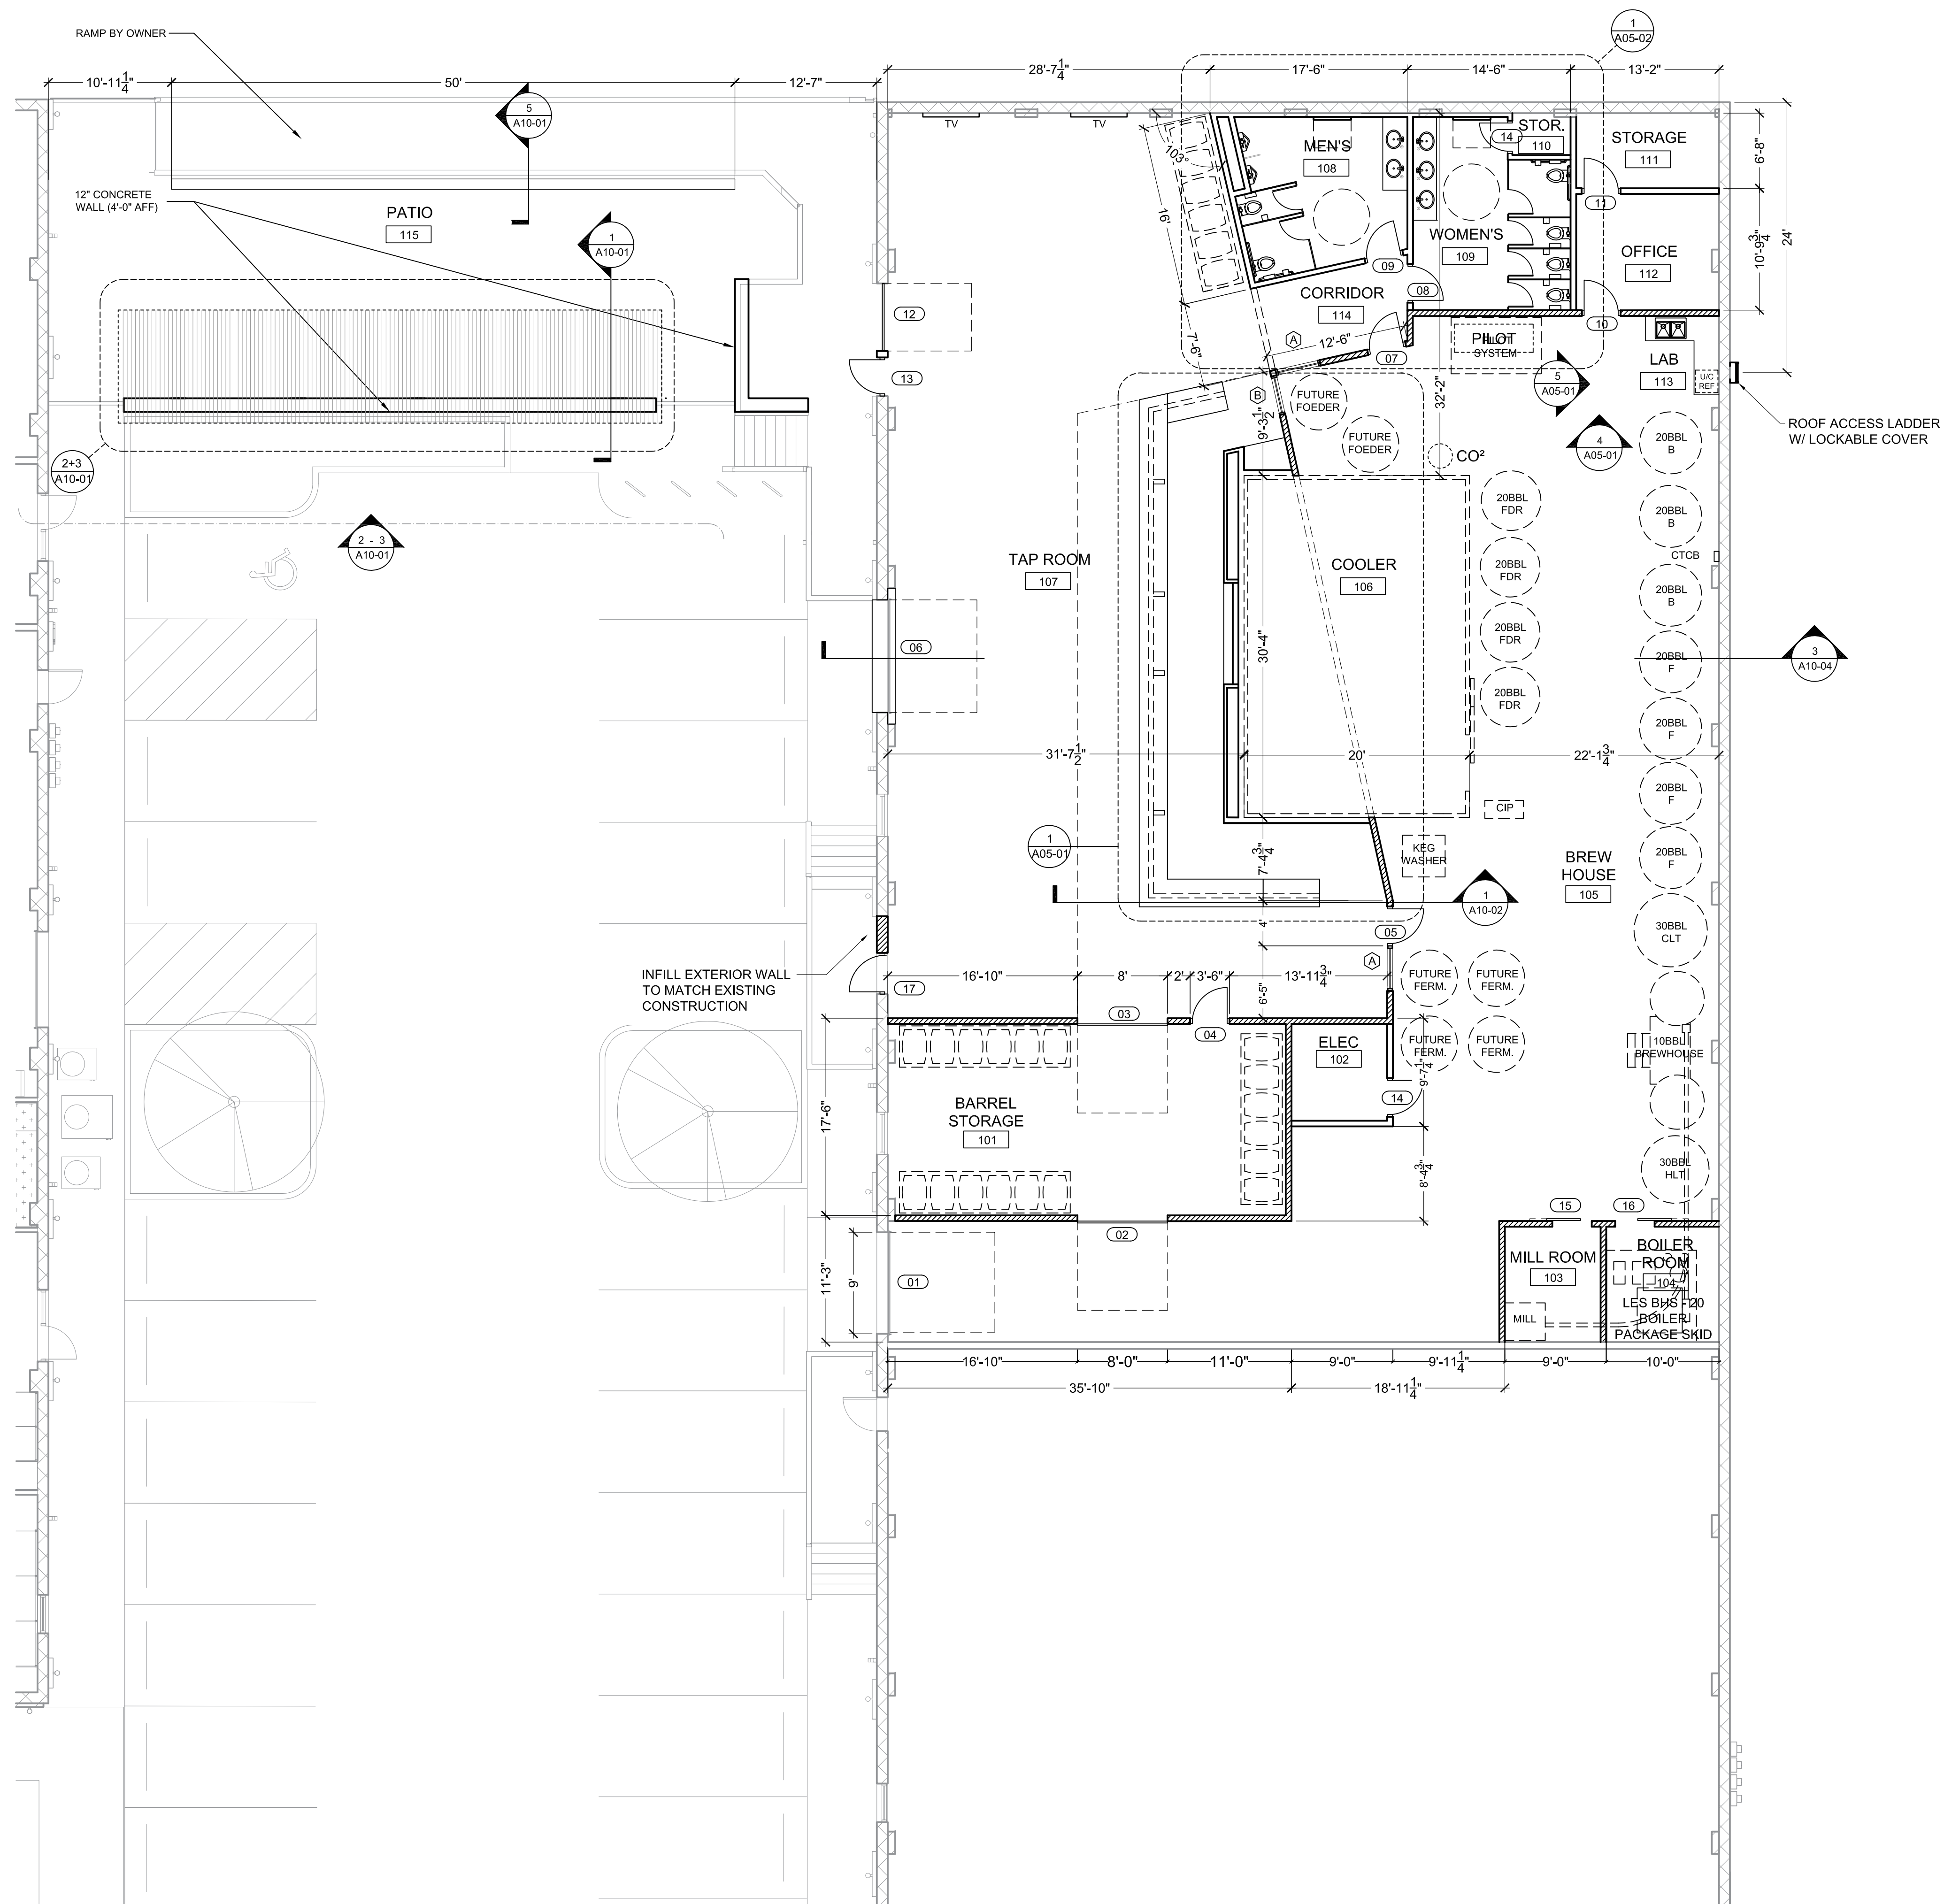


- FLOOR PLAN GENERAL NOTES**
1. ALL TAP ROOM FURNITURE OFOI - SHOWN FOR REPRESENTATION ONLY.
 2. ALL BREWING EQUIPMENT AND BARREL STORAGE RACKS (INCLUDING COOLER) TO BE PROVIDED/INSTALLED BY OWNER.
 3. WALLS EXTENDING TO DECK (SHOWN SHADED) TO BE 6" MTL STUDS WITH 5/8" GWB EACH SIDE. ALL OTHER WALLS TO BE 3 5/8" MTL STUDS WITH 5/8" GWB EACH SIDE, TYP.
 4. ALL FLOOR DRAINS TO BE LOCATED PER A01-01
 5. ALL ROOF PENETRATIONS TO BE A MINIMUM OF 4'-0" FROM EDGE OF ROOF.
 6. ALL DOORS TO BE LOCATED MIN. 4" FROM INTERIOR SWING WALL U.N.O.

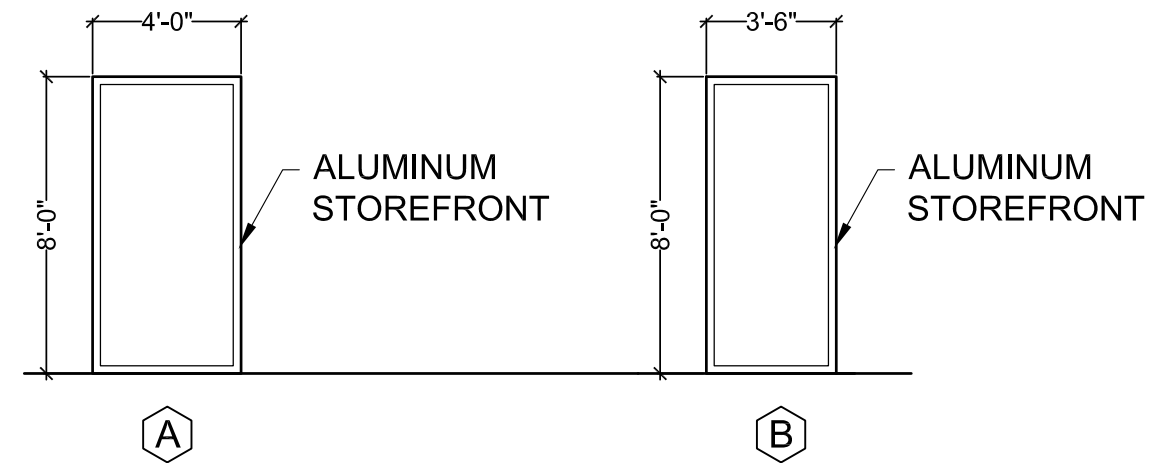

3 GLAZING TYPES

#	WIDTH	HEIGHT	TYPE	FRAME	FINISH	NOTES
01	9'-0"	9'-0"	EXISTING	---	---	
02	8'-0"	8'-0"	B - STEEL OVHD ROLL-UP DOOR	---	PT	
03	8'-0"	8'-0"	B - STEEL OVHD ROLL-UP DOOR	---	PT	
04	3'-0"	8'-0"	A - FLUSH WOOD DOOR	HM	STD WD	
05	3'-0"	8'-0"	A - FLUSH WOOD DOOR	HM	STD WD	DOOR TO HAVE CHEMICAL RESISTANT WATERPROOF SWEEP
06	10'-0"	5'-0"	EXISTING	---	---	
07	3'-0"	8'-0"	A - FLUSH WOOD DOOR	HM	STD WD	DOOR TO HAVE CHEMICAL RESISTANT WATERPROOF SWEEP
08	3'-0"	8'-0"	A - FLUSH WOOD DOOR	HM	STD WD	
09	3'-0"	8'-0"	A - FLUSH WOOD DOOR	HM	STD WD	
10	3'-0"	8'-0"	A - FLUSH WOOD DOOR	HM	STD WD	DOOR TO HAVE CHEMICAL RESISTANT WATERPROOF SWEEP
11	3'-0"	8'-0"	A - FLUSH WOOD DOOR	HM	STD WD	
12	6'-0"	7'-0"	C - GLAZED ROLL-UP DOOR	---	---	
13	3'-0"	7'-0"	D - GLAZED STOREFRONT DOOR	---	---	EMERGENCY EGRESS HARDWARE, CLOSER
14	2'-6"	8'-0"	E - FLUSH STEEL DOOR	HM	PT	60 MIN RATED, EMERGENCY EGRESS HARDWARE, CLOSER
15	3'-0"	8'-0"	A - FLUSH WOOD DOOR	HM	STD WD	SURFACE MOUNTED
16	3'-0"	8'-0"	A - FLUSH WOOD DOOR	HM	STD WD	SURFACE MOUNTED
17	3'-0"	8'-0"	E - FLUSH STEEL DOOR	HM	PT	45 MIN RATED, EMERGENCY EGRESS HARDWARE, CLOSER

1. ALL DOORS TO HAVE FLOOR MOUNTED STOPS PROVIDED AND POSITIONED TO PREVENT COLLISION WITH WALLS SURFACES, EQUIPMENT ETC.

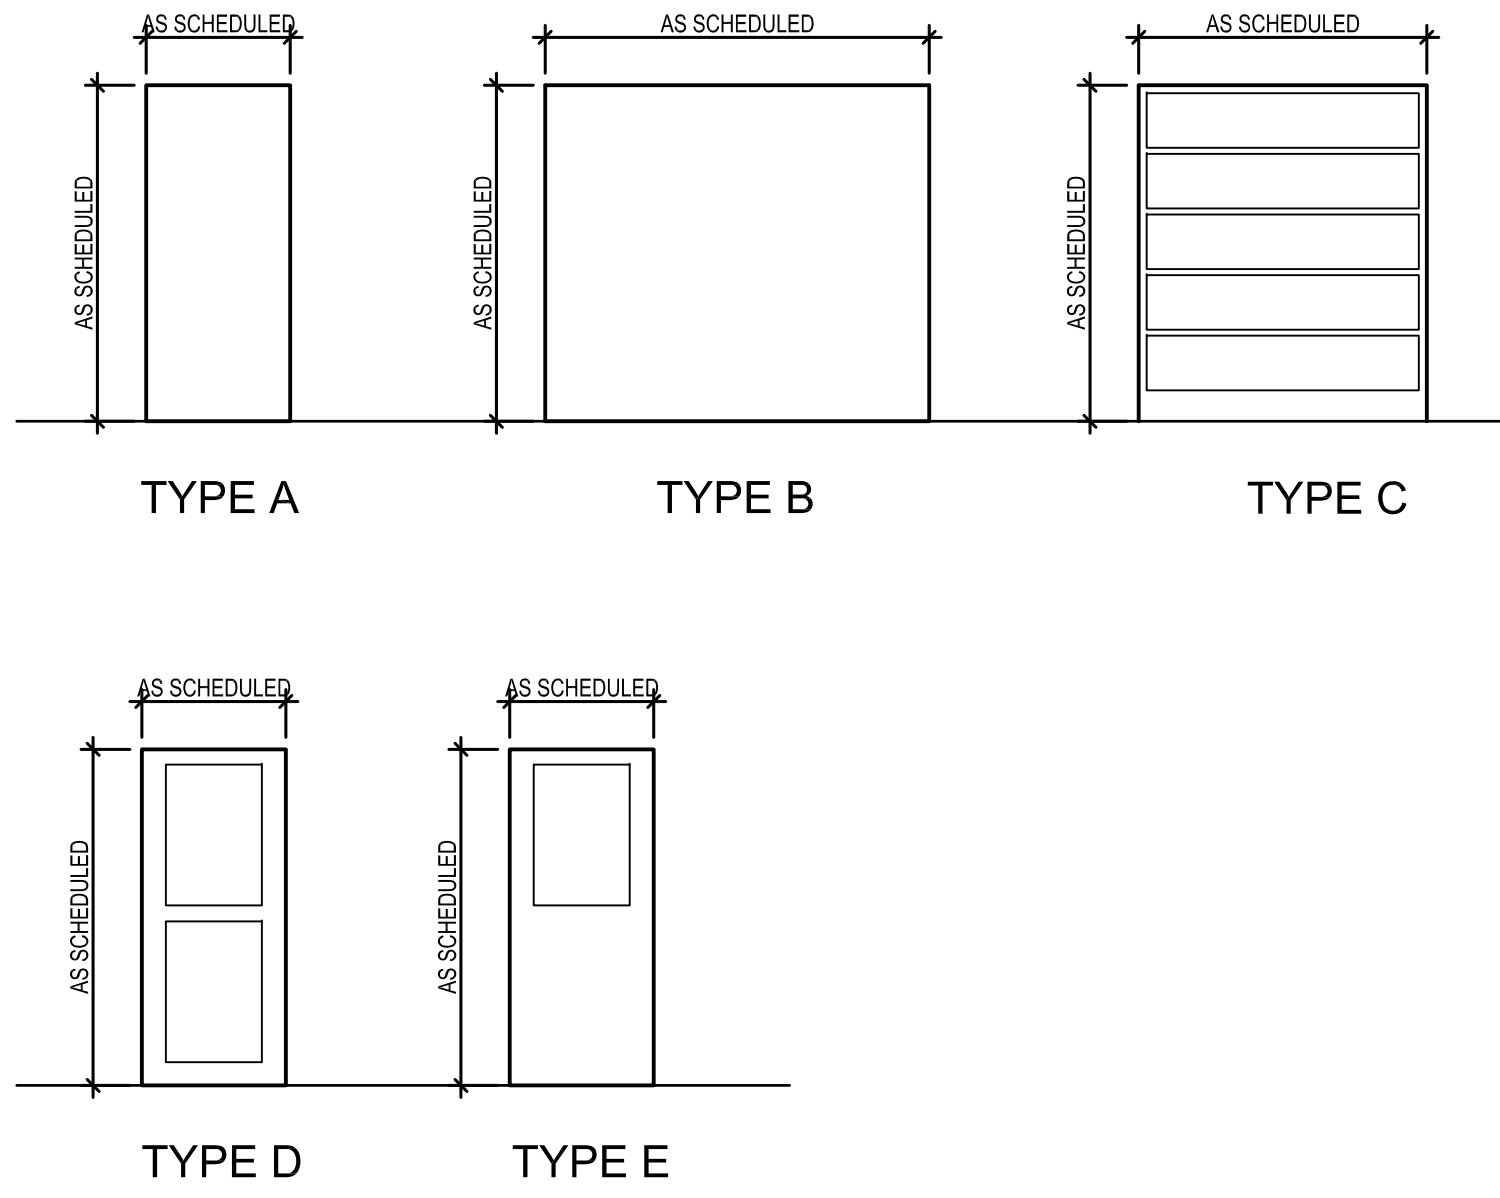

1 DOOR TYPES

Architecture
NEAR DESIGN WORKSHOP
3537 Annlin Ave
Charlotte, NC 28209

Structural
Hunter Structural PA
1900 Abbott St #103
Charlotte, NC 28203

Mechanical
VP Engineering
1414-C South Tryon Street
Charlotte, NC 28203

Electrical
VP Engineering
1414-C South Tryon Street
Charlotte, NC 28203

Plumbing
VP Engineering
1414-C South Tryon Street
Charlotte, NC 28203

DIVINE BARREL BREWING
NODA STREET MARKET
3929-3701 N. DAVIDSON STREET
CHARLOTTE, NC 28205

STAMP

REVISIONS

#	TITLE	DATE

FLOOR PLAN
SHEET TITLE
A01-02
SHEET ID

2 FLOOR PLAN

SCALE: 1/8" = 1' - 0"

1 DOOR TYPES

NEAR DESIGN WORKSHOP



● COLLABORATIVE AREAS